IREDELL COUNTY HEALTH DEPARTMENT

STATESVILLE 704-878-5305 MOORESVILLE 704-664-5281

IMPROVEMENT PERMIT / AUTHORIZATION TO CONSTRUCT / OPERATION PERMIT / EXISTING SYSTEM INSPECTION

PERMIT# 18706 PIN# 4626 38 4001. 343 4626278300 DATE 6/21/04

OWNER OR CONTRACTOR THE FARMS LLC / ES JOHNSON ELDRS. PHONE: Business 660-1185 Home

ADDRESS 214 BRAWLEY SCHOOL - MOORESVILLE - 28115

LOCATION BRAWLEY SCHOOL - TR McKENDREE - TL ~~KENDREE~~ - TR ALDAR SRS. TL BAYBERRY - TR - ANDERSON - ON RT

SUBDIVISION THE FARMS BLOCK / SECTION 3 LOT 343 LOT AREA 1.78AC SITE CLASS. CS DESIGN FLOW 980GPD L.T.A.R. - 36.00/FT

Septic Tank: 1000 Gallons; STB 538 Date 1-23-05
Pump Tank: 1000 Gallons; PT 27 Date 1-14-05
Pump Make: Goulds Model VUE0312MU Serial No.
Nitrification Field: No Fields 1 Square Feet 1200 Linear Feet 400
No Lines 4@100' Trench Width 36" Max Trench Bottom Depth 36" Gravel Depth N/A

☑ New System ☐ Repair System Type: I, II, III, IV, V, VI
System Description: PUMP 25% REDUCTION
Repair System Description: LP PANEL
Maintenance Agreement Required: ☐ Yes ☑ No


☑ House/Mod. Home No. Bedrooms 4
☐ Mobile Home No. Bathrooms 4
☐ Business No. Employees
☐ Other
☐ Slab ☑ Crawl Space ☐ Basement w/plumbing ☐ Basement wo/plumbing

Water Supply: ☐ Individual ☐ Public ☑ Community

Comments/Conditions:


Comments/Conditions: Checked tanks & lines 5/12/05
Pressure, elect & alarm 7/18/05

1"=50' INITIAL SITE SKETCH

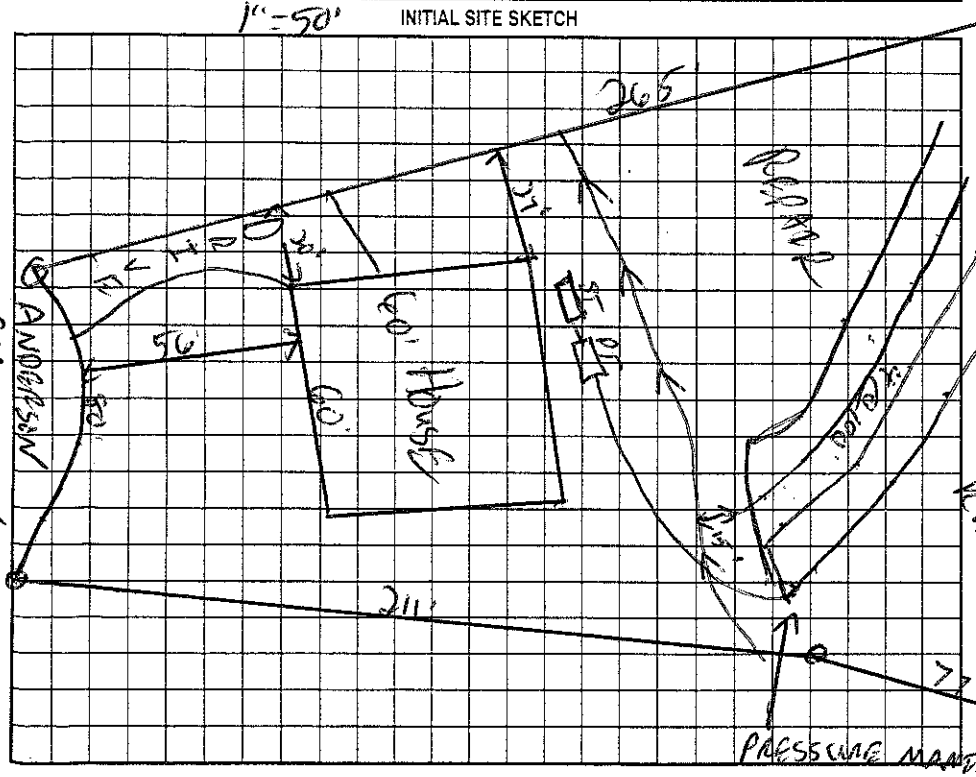

AS BUILT SKETCH

Installed Plastic Chambers (Quick 4)
As Drawn

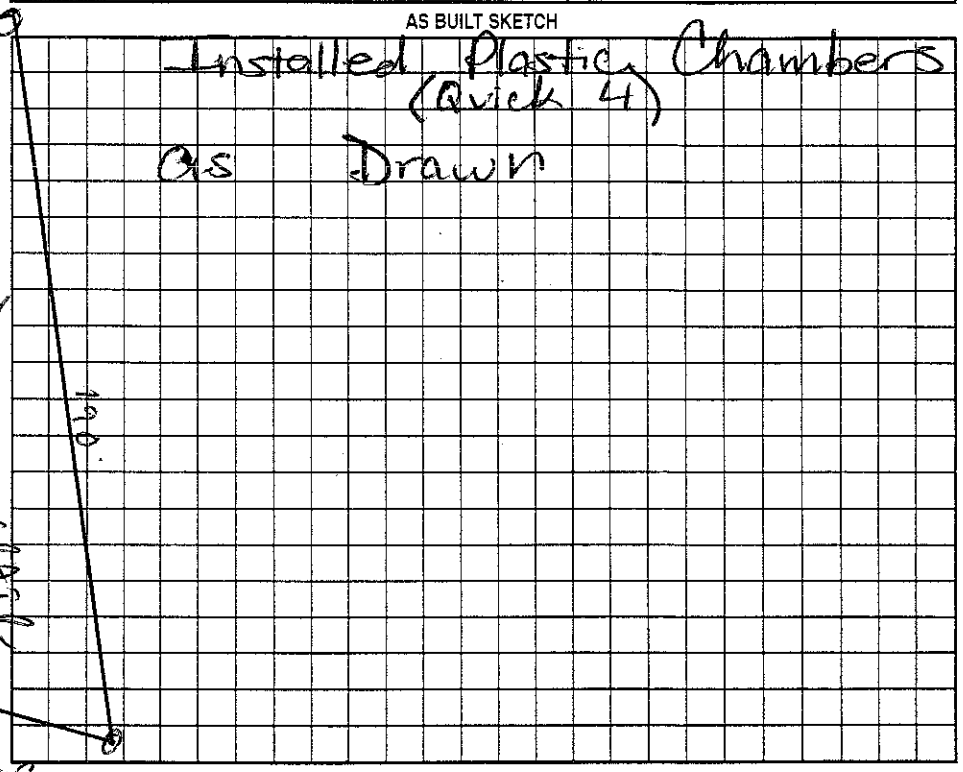

Permit can be suspended or revoked if any false information is supplied toward securing the permit/any unauthorized changes are made to the site/any unauthorized changes are made in the installation of the system. Improvement Permit with plat valid without expiration. Improvement Permit with site plan valid for sixty months. Authorization to Construct is valid for a period equal to that of Improvement Permit – not to exceed sixty months.

Signed: [signature] date 7-12-04 Installed by: Willie Christenbury RS

Improvement Permit by: [signature] RS date 6/21/04 Operation Permit by: [signature] date 7/18/05

Authorization to Construct by: [signature] RS date 12/29/04 Existing System Inspection by: date

HEALTH DEPT. COPY: WHITE OWNER COPY (FINAL): YELLOW OWNER COPY (INITIAL): PINK