IREDELL COUNTY HEALTH DEPARTMENT

STATESVILLE 704-878-5305 MOORESVILLE 704-664-5281

IMPROVEMENT PERMIT / AUTHORIZATION TO CONSTRUCT / OPERATION PERMIT / EXISTING SYSTEM INSPECTION

PERMIT# 18704 PIN# 4626 38 4001.341 4626279196 DATE 6/18/04

OWNER OR CONTRACTOR FARMS LLC / John R. Poore Bldr. PHONE: Business 660-1185 Home

ADDRESS 2214 BRAWLEY SCHOOL RD MOORESVILLE NC 28115

LOCATION BRAWLEY SCHOOL - TR MCGNORGLE - TL KEMP - TR ALDER SPRINGS - TL BAYBERRY - ON RT

SUBDIVISION TIREFARMS BLOCK / SECTION 3 LOT 341 LOT AREA 1.76A SITE CLASS. RS DESIGN FLOW 480GPD L.T.A.R. 2560GPD/1.92

Septic Tank: 1000 Gallons: STB 338 Date 1-21-07

Pump Tank: 1000 Gallons: PT 283 Date 1-16-07

Pump Make: Goulds Model WE0312 Serial No.

Nitrification Field: No Fields 1 Square Feet 1440 Linear Feet 480

No Lines 5@96' Trench Width 36" Max Trench Bottom Depth 36" Gravel Depth 4/9

☑ New System ☐ Repair System Type: I, II, III, IV, V, VI

System Description: PUMP 25% REDUCTION

Repair System Description: CP PANEL

Maintenance Agreement Required: ☐ Yes ☑ No

☑ House/Mod. Home ☐ Mobile Home ☐ Business ☐ Other

No. Bedrooms 4 No. Bathrooms 4 No. Employees

Water Supply: ☐ Individual ☐ Public ☑ Community

☐ Slab ☐ Crawl Space ☑ Basement w/plumbing ☐ Basement wo/plumbing

Comments:/Conditions:


Comments:/Conditions: PARTIAL

Installed EZ Flow 2/28/07


4 tanks

Pressure, elect alarm

INITIAL SITE SKETCH

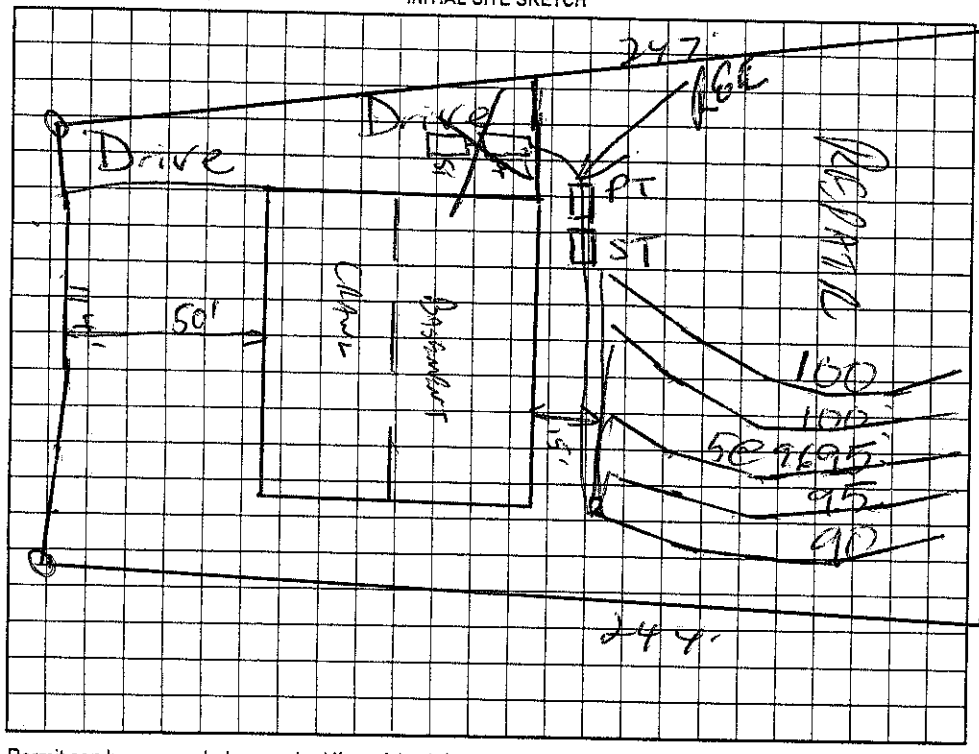

AS BUILT SKETCH

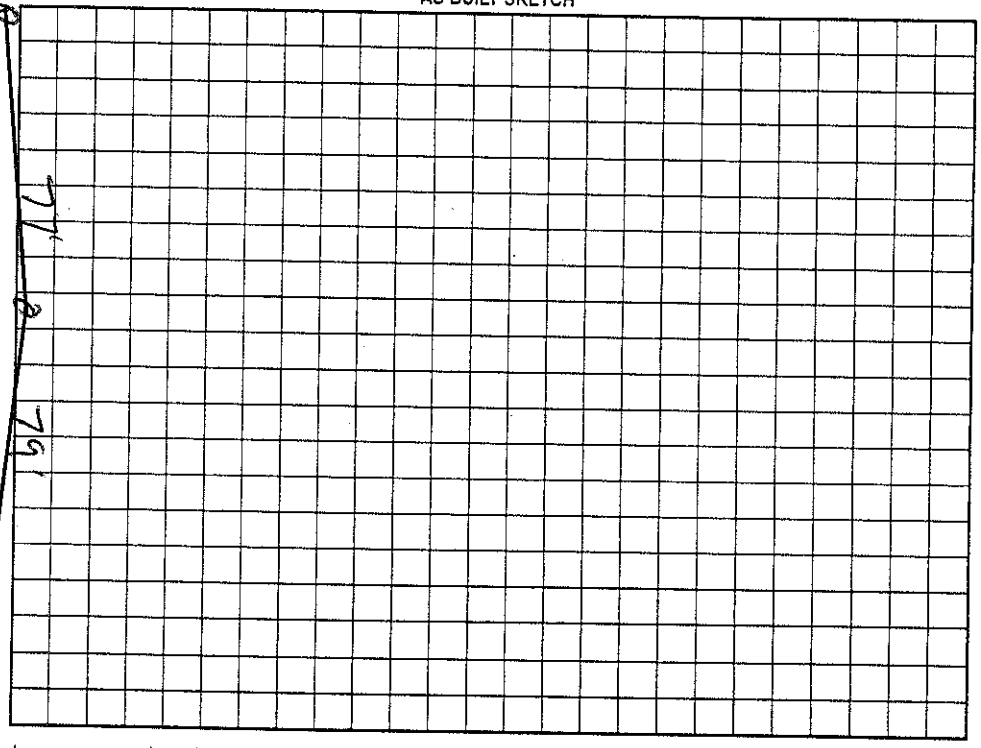

Permit can be suspended or revoked if any false information is supplied toward securing the permit/any unauthorized changes are made to the site/any unauthorized changes are made in the installation of the system. Improvement Permit with plat valid without expiration. Improvement Permit with site plan valid for sixty months. Authorization to Construct is valid for a period equal to that of Improvement Permit – not to exceed sixty months.

Signed: date 7-12-04 Installed by: R&H

Improvement Permit by: date 6/18/04 Operation Permit by: Maria H. Dotson RS date 3/15/07

Authorization to Construct by: date 11/17/05 Existing System Inspection by: date

HEALTH DEPT. COPY: WHITE OWNER COPY (FINAL): YELLOW OWNER COPY (INITIAL): PINK