4626280200

IREDELL COUNTY HEALTH DEPARTMENT

STATESVILLE 704-878-5305 MOORESVILLE 704-664-5281

IMPROVEMENT PERMIT / AUTHORIZATION TO CONSTRUCT / OPERATION PERMIT / EXISTING SYSTEM INSPECTION

PERMIT# 118590 PIN# 4626 38 4001.311 DATE 2/3/05

OWNER OR CONTRACTOR THE FARMS LLC / Keary Const PHONE: Business Home

ADDRESS 2214 BRAWLEY School Rd - Mooresville NC 28115

LOCATION BRAWLEY School - TR McKNORREE - TR Parkland - TR BAYBERRY - ON RT

SUBDIVISION THE FARMS BLOCK / SECTION 3 LOT 311 LOT AREA 1.33AC SITE CLASS. RS DESIGN FLOW 480GPD L.T.A.R. .36/1.52

Septic Tank: 1000 Gallons; STB 338 Date 4-10-06
Pump Tank: Gallons; PT Date
Pump Make: Model Serial No.
Nitrification Field: No Fields 1 Square Feet 1596 Linear Feet 532
No Lines 4@133' Trench Width 36" Max Trench Bottom Depth 36" Gravel Depth N/A


☑ New System ☐ Repair System Type: I, II, III, IV, V, 25% Reduction
System Description: GRAVITY CONVENTIONAL
Repair System Description: GRAV. 25% REDUCTION
Maintenance Agreement Required: ☐ Yes ☑ No

☑ House/Mod. Home No. Bedrooms 4
☐ Mobile Home No. Bathrooms 4
☐ Business No. Employees
☐ Other
☐ Slab ☑ Crawl Space ☐ Basement w/plumbing ☐ Basement wo/plumbing

Water Supply:
☐ Individual
☐ Public
☑ Community

Comments:/Conditions:


INITIAL SITE SKETCH

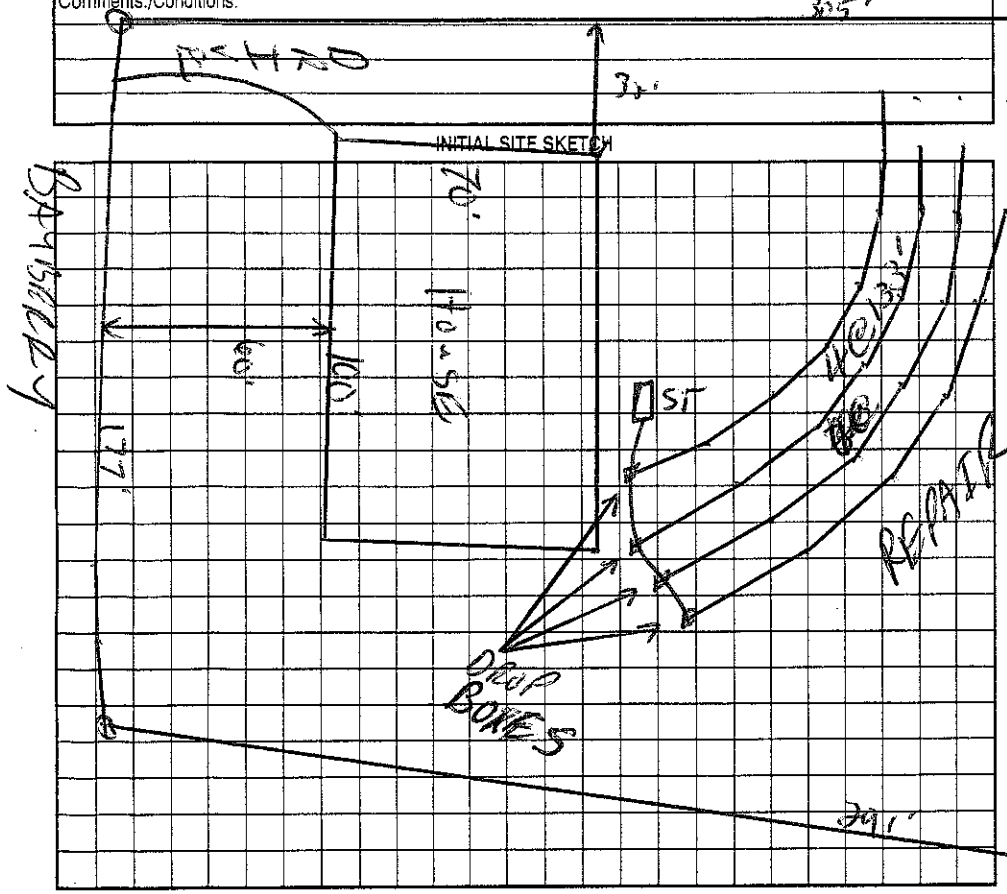

Comments:/Conditions:

1"=50'

AS BUILT SKETCH

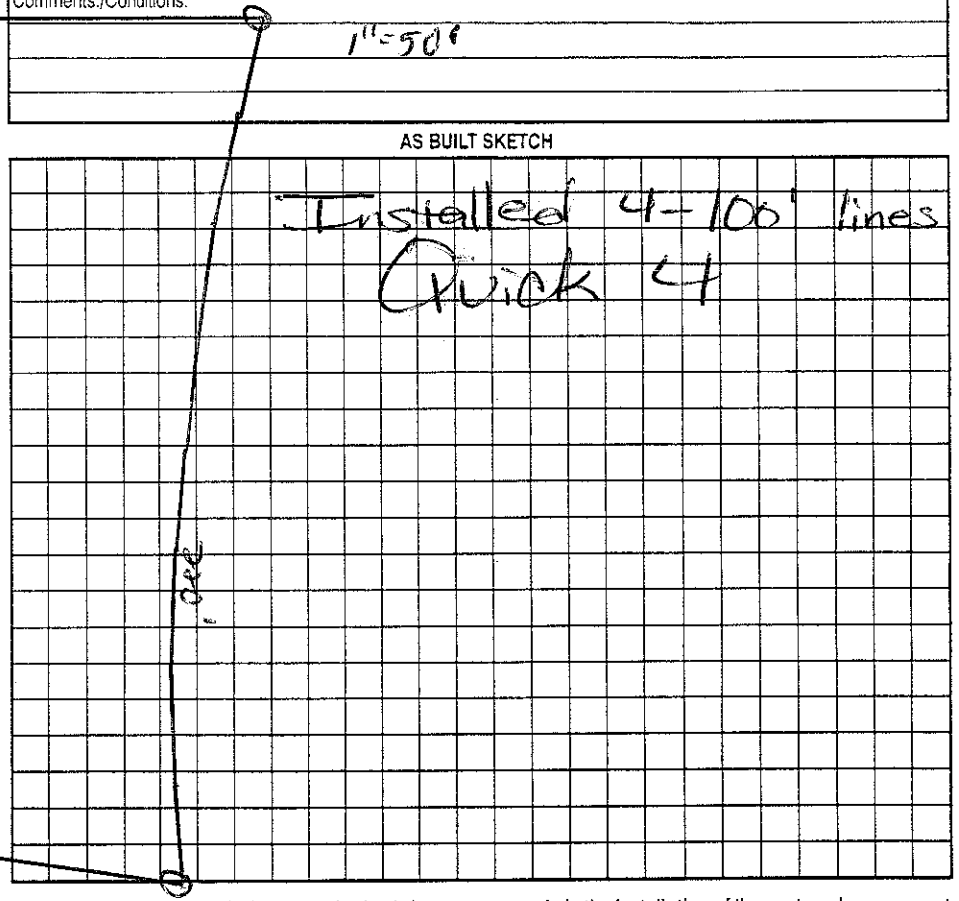

Permit can be suspended or revoked if any false information is supplied toward securing the permit/any unauthorized changes are made to the site/any unauthorized changes are made in the installation of the system. Improvement Permit with plat valid without expiration. Improvement Permit with site plan valid for sixty months. Authorization to Construct is valid for a period equal to that of Improvement Permit – not to exceed sixty months.

Signed: date 2-24-05 Installed by: date

Improvement Permit by: RS date 2/3/05 Operation Permit by: RS date 8/9/06

Authorization to Construct by: RS date 12/2/05 Existing System Inspection by: date

HEALTH DEPT. COPY: WHITE OWNER COPY (FINAL): YELLOW OWNER COPY (INITIAL): PINK