2.0

IREDELL COUNTY HEALTH DEPARTMENT

STATESVILLE 704-878-5305 MOORESVILLE 704-664-5281

IMPROVEMENT PERMIT / AUTHORIZATION TO CONSTRUCT / OPERATION PERMIT / EXISTING SYSTEM INSPECTION

PERMIT# 119671 PIN# 4625505104.438 4626-28-1600 DATE 2-2-07

OWNER OR APPLICANT Arcadia Homes PHONE: Business 662-6631 Home 201-7181

ADDRESS P.O. Box 471941 Charlotte, NC 28247

LOCATION Brawley School Rd

SUBDIVISION The Farms BLOCK / SECTION 3 LOT 438 LOT AREA 1.12 Acre SITE CLASS. PS DESIGN FLOW 600gpd T.A.R. .3

Septic Tank: 1500 Gallons; STB 338 Date 9-17-06

Pump Tank: 1500 Gallons; PT 477 Date ~~9-27-06~~

Pump Make: Goulds Model WE0312M1 Serial No. 2-2-07

Nitrification Field: No Fields 1 Square Feet 1005 Linear Feet 335'

X Lines 5 (See Note) Trench Width 36" Max Trench Bottom Depth 36"

X New System ☐ Repair ☐ Expansion System Type: I II III IV V VI

System Description: Pump-LP-Panel BR

Repair System Description: Same

Maintenance Agreement Required: X Yes ☐ No

Gravel Depth N/A ☐ Gravity X Pressure

☐ House/Mod. Home ☐ Mobile Home ☐ Business ☐ Other

No. Bedrooms 5 No. Persons ___ No. Employees ___


Water Supply: ☐ Individual X Public X Community

☐ Slab ☐ Crawl Space ☐ Basement w/plumbing ☐ Basement wo/plumbing

Comments:/Conditions:


Scale 1:50

INITIAL SITE SKETCH

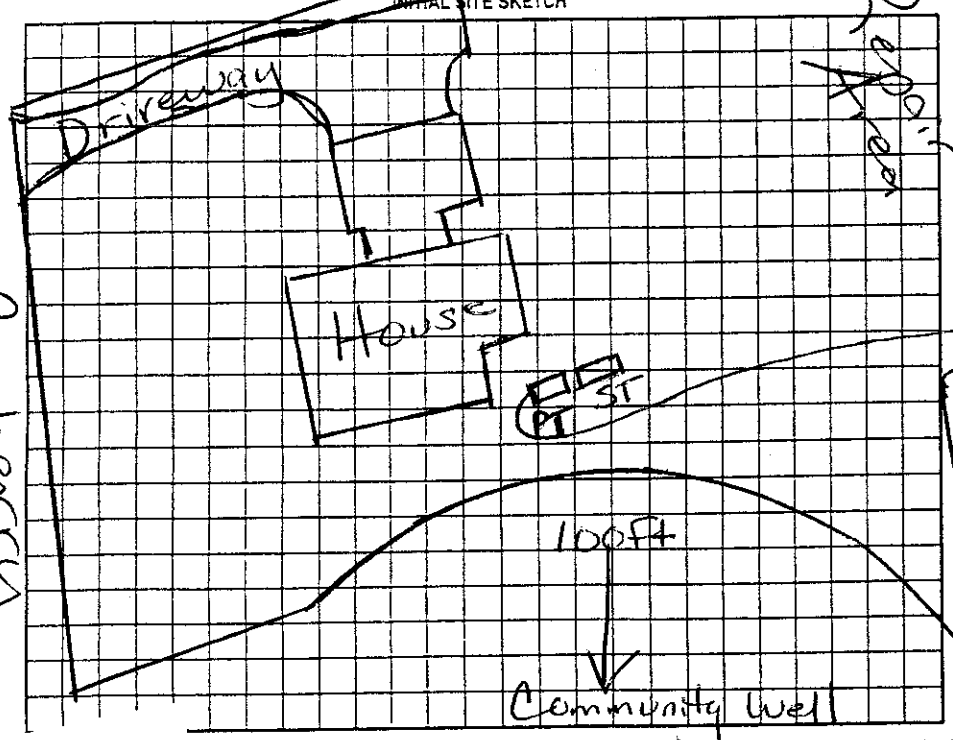

Comments:/Conditions: Upgrading to 5 Bedroom
*Add one (55Ft) drainline to System & change PT to 1500g.
Checked PT & extra Panel line 3 ✓

AS BUILT SKETCH

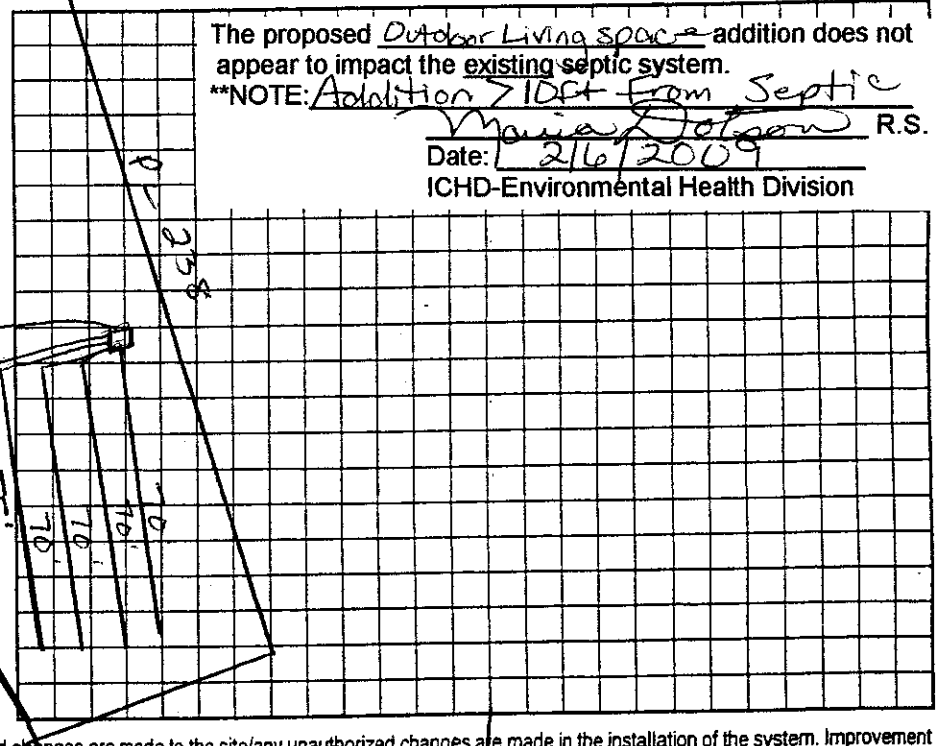

The proposed Outdoor Living space addition does not appear to impact the existing septic system.

**NOTE: Addition >10Ft From Septic

Maria Dotson R.S.


ICHD-Environmental Health Division

ended or revoked if any false information is supplied toward securing the permit/any unauthorized changes are made to the site/any unauthorized changes are made in the installation of the system. Improvement
f without expiration ☐ Improvement Permit with site plan valid for sixty months ☐ Authorization to Construct is valid for a period equal to that of Improvement Permit – not to exceed sixty months.

S. EV date 2/8/07

Improve. y: Maria H. Dotson RS date 2/6/07 Installed by: R&H RS

Authorization to uct by: Maria H. Dotson RS date 2/6/07 Operation Permit by: Maria H. Dotson date 3/7/07

Existing System Inspection by: ___ date ___

HEALTH DEPT. COPY: WHITE OWNER COPY (FINAL): YELLOW OWNER COPY (INITIAL): PINK