375

IREDELL COUNTY HEALTH DEPARTMENT

STATESVILLE 704-878-5305 MOORESVILLE 704-664-5281

IMPROVEMENT PERMIT / AUTHORIZATION TO CONSTRUCT / OPERATION PERMIT / EXISTING SYSTEM INSPECTIO

PERMIT# 119671 PIN# 4625 50 5104 435 DATE 1/3/05

OWNER OR CONTRACTOR THE FARMS LLC / Arcadia PHONE: Business Home

ADDRESS 2214 BRAWLEY SCHOOL RD MOORESVILLE NC 28115

LOCATION BRAWLEY SCHOOL - TR McKENDREE - DEVELOPMENT - TR BAYBERRY - ON LT

SUBDIVISION THE FARMS BLOCK / SECTION 3 LOT 435 LOT AREA 1.12AC SITE CLASS PS DESIGN FLOW 480 GPD L.T.A.R. .36/.47=

Septic Tank: 1000 Gallons; STB 338 Date 9-11-06

Pump Tank: 1000 Gallons; PT 253 Date 9-27-06

Pump Make: Goulds Model WE0512M Serial No.

Nitrification Field: No Fields 1 Square Feet 560 Linear Feet 280

No Lines 4@70' Trench Width 24" Max Trench Bottom Depth 36" Gravel Depth

☑ New System ☐ Repair System Type: I, II, III, ⓘ, V, VI

System Description: LP PANEL

Repair System Description: SAME

Maintenance Agreement Required: ☑ Yes ☐ No

☑ House/Mod. Home No. Bedrooms 4

☐ Mobile Home No. Bathrooms 4

☐ Business No. Employees

☐ Other

☐ Slab ☑ Crawl Space ☐ Basement w/plumbing ☐ Basement wo/plumbing


Water Supply: ☐ Individual ☐ Public ☑ Community

Comments:/Conditions:

1" = 50' 30'


Comments:/Conditions: Inspected tanks 11/1/06

INITIAL SITE SKETCH

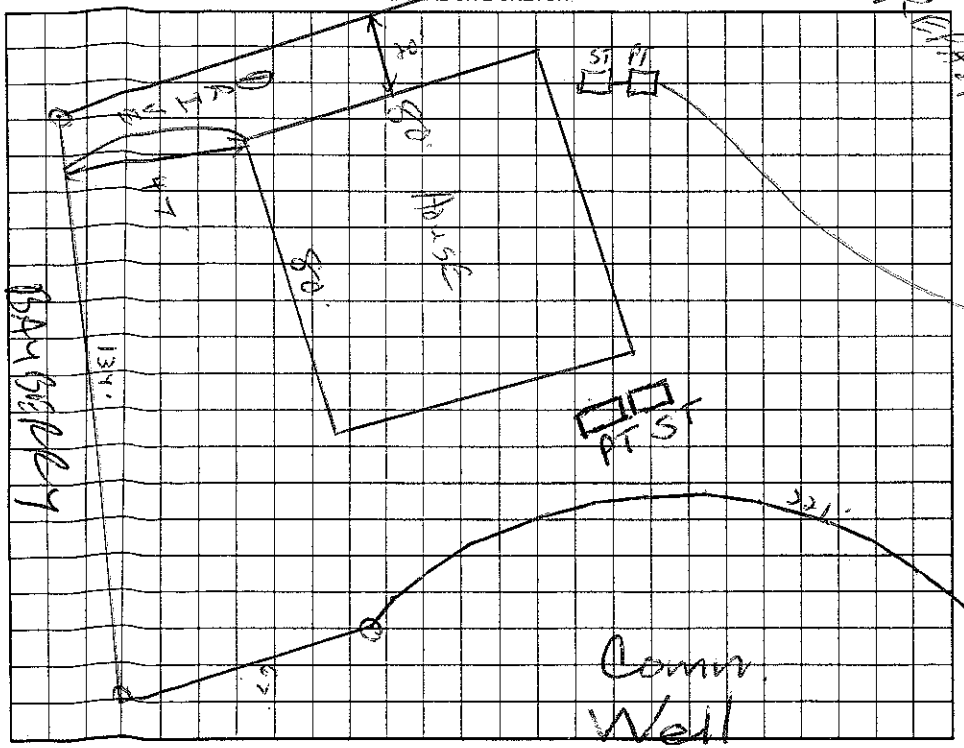

AS BUILT SKETCH

Installed Panels as Drawn 4@70' 11/2/06

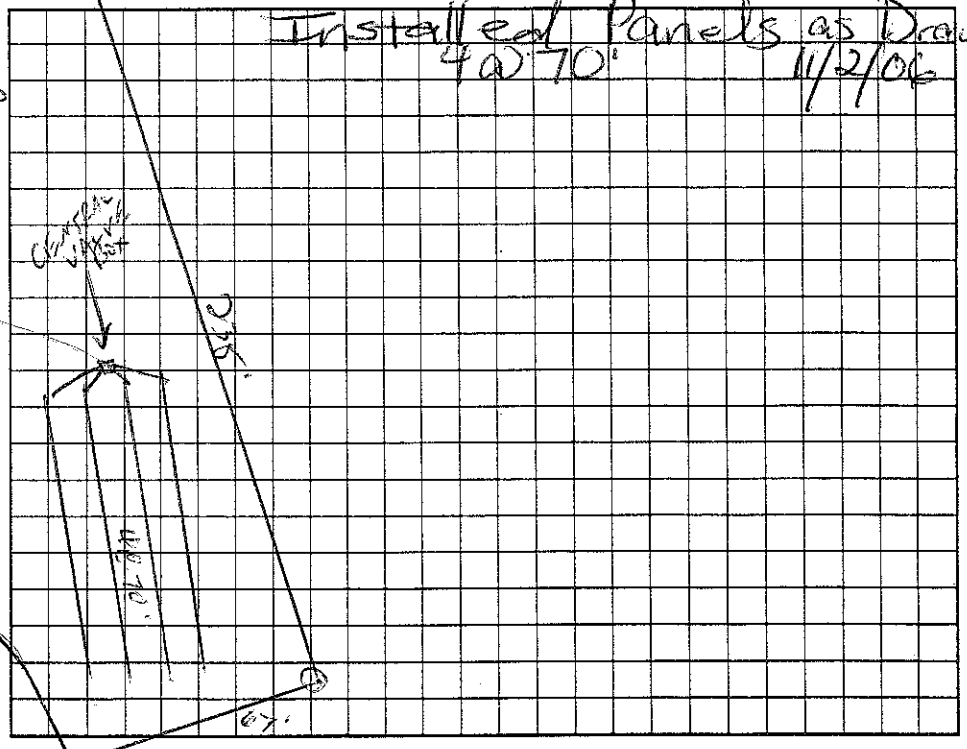

Permit can be suspended or revoked if any false information is supplied toward securing the permit/any unauthorized changes are made to the site/any unauthorized changes are made in the installation of the system. Improvement Permit with plat valid without expiration. Improvement Permit with site plan valid for sixty months. Authorization to Construct is valid for a period equal to that of Improvement Permit – not to exceed sixty months.

Signed: date 2-24-05 Installed by: R&H

Improvement Permit by: date 1/3/05 Operation Permit by: date

Authorization to Construct by: date 5-3-06 Existing System Inspection by: date

HEALTH DEPT. COPY: WHITE OWNER COPY (FINAL): YELLOW OWNER COPY (INITIAL): PINK