IREDELL COUNTY HEALTH DEPARTMENT

STATESVILLE 704-878-5305 MOORESVILLE 704-664-5281

IMPROVEMENT PERMIT / AUTHORIZATION TO CONSTRUCT / OPERATION PERMIT / EXISTING SYSTEM INSPECTION

PERMIT# 118597 PIN# 4626-35-4001.314 4626283385 DATE 11/23/04

OWNER OR CONTRACTOR THE FARMS LLC / T. Wheelan Homes PHONE: Business 663-6985 Home

ADDRESS 2214 BRANLEY SCHOOL RD. MOORESVILLE NC 28115

LOCATION BRANLEY SCHOOL - TR MCMANORAE - ~~MANNAH~~ TR BAMBERRY - ON RT

SUBDIVISION THE FARMS BLOCK / SECTION II LOT 314 LOT AREA 1.24AC SITE CLASS. PS DESIGN FLOW 450GPD L.T.A.R. .3000/FT

Septic Tank: ~~1500~~ 1500 Gallons; STB 338 Date 3/5/06

Pump Tank: Gallons; PT Date

Pump Make: Model Serial No.

Nitrification Field: No Fields 1 Square Feet 1200 Linear Feet 400

No Lines 4@100' Trench Width 36" Max Trench Bottom Depth 36" Gravel Depth N/A

☑ New System ☐ Repair System Type: I, II, III, IV, V, VI

System Description: GRAVITY 25% REDUCTION

Repair System Description: LP PANEL

Maintenance Agreement Required: ☐ Yes ☑ No

☑ House/Mod. Home No. Bedrooms 4

☐ Mobile Home No. Bathrooms 4

☐ Business No. Employees

☐ Other


☐ Slab ☑ Crawl Space ☐ Basement w/plumbing ☐ Basement wo/plumbing

Water Supply: ☐ Individual ☑ Public ☐ Community


Comments:/Conditions:

Comments:/Conditions:

INITIAL SITE SKETCH

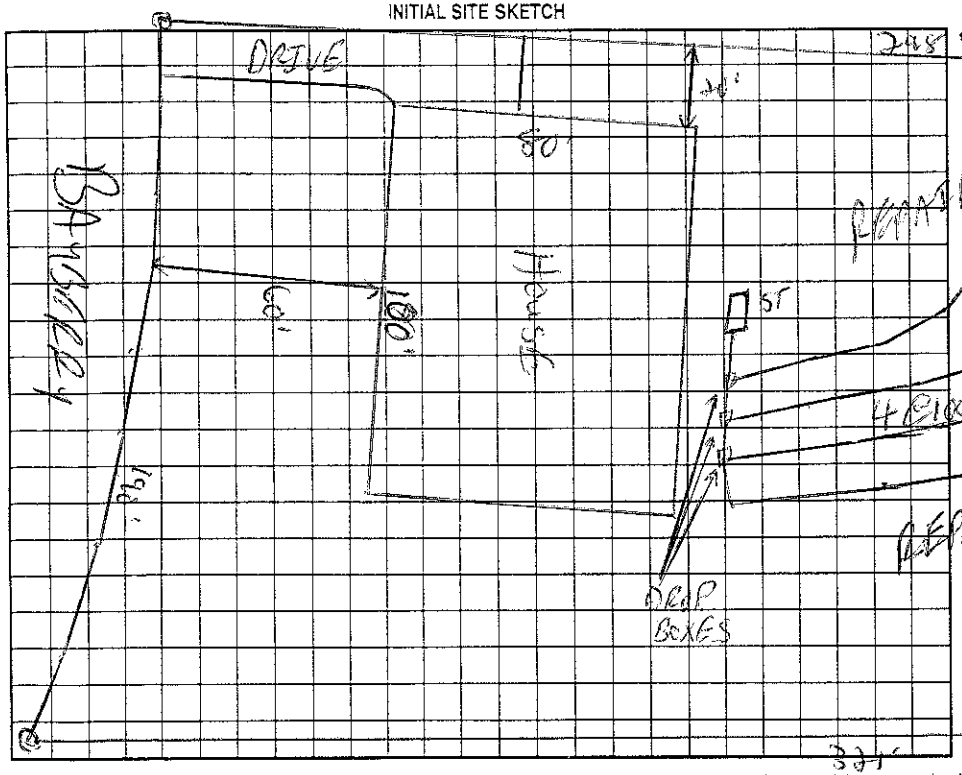

AS BUILT SKETCH 1"=50'

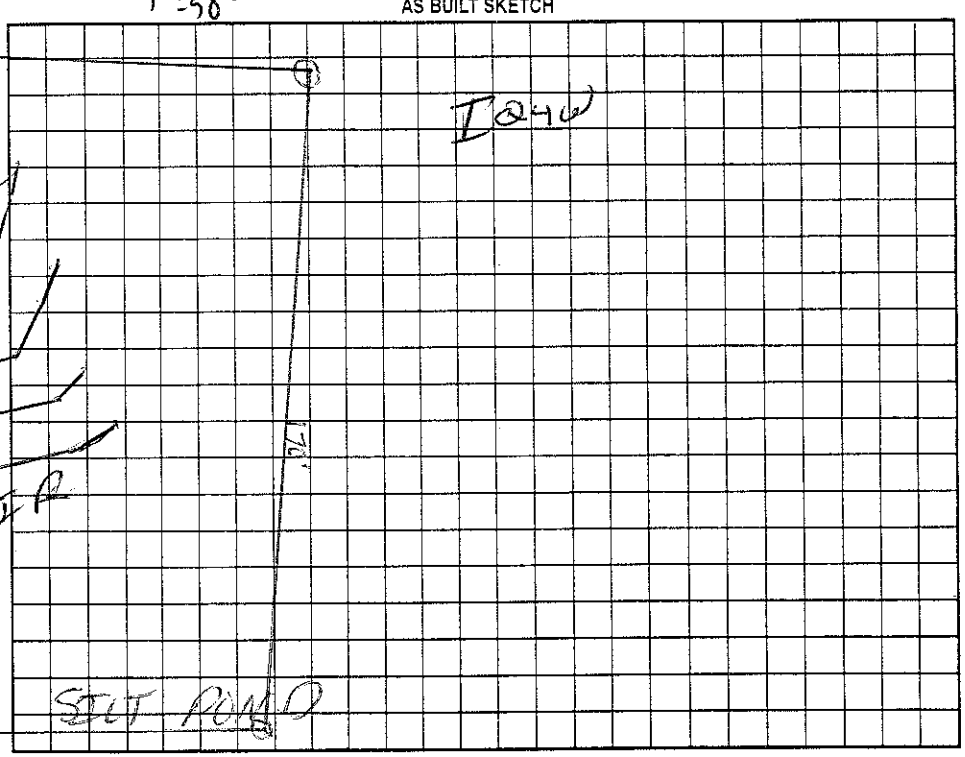

Permit can be suspended or revoked if any false information is supplied toward securing the permit/any unauthorized changes are made to the site/any unauthorized changes are made in the installation of the system. Improvement Permit with plat valid without expiration. Improvement Permit with site plan valid for sixty months. Authorization to Construct is valid for a period equal to that of Improvement Permit – not to exceed sixty months.

Signed: date 2-24-05 Installed by: Larry Beam

Improvement Permit by: date 11/23/04 Operation Permit by: date 4/11/06

Authorization to Construct by: date 12/25/05 Existing System Inspection by: date

HEALTH DEPT. COPY: WHITE OWNER COPY (FINAL): YELLOW OWNER COPY (INITIAL): PINK