13 - 3:00

IREDELL COUNTY HEALTH DEPARTMENT

STATESVILLE 704-878-5305 MOORESVILLE 704-664-5281

IMPROVEMENT PERMIT / AUTHORIZATION TO CONSTRUCT / OPERATION PERMIT / EXISTING SYSTEM INSPECTION

PERMIT# 18599 PIN# 4626 38 4001 315 4626285442 DATE 11/23/04

OWNER OR CONTRACTOR THE FARMS LLC / Kendal Painter PHONE: Business 663-6905 Home

ADDRESS 2214 BRAWLEY SCHOOL RD MOORESVILLE NC 28115

LOCATION BRAWLEY SCHOOL - TR McKENDREE - TANNAMAR TL BAY BERRY - ONRS

SUBDIVISION THE FARMS BLOCK / SECTION III LOT 315 LOT AREA .924c SITE CLASS. PS DESIGN FLOW 450GPD L.T.A.R. .36 AM/FM

Septic Tank: 1000 Gallons; STB 338 Date 9-25-05

Pump Tank: Gallons; PT Date

Pump Make: Model Serial No.

Nitrification Field: No Fields 1 Square Feet 1200 Linear Feet 400

No Lines 4@100' Trench Width 36" Max Trench Bottom Depth 36" Gravel Depth N/A

☑ New System ☐ Repair System Type: I, II, (III), IV, V, VI

System Description: 6 CAJ-7 25% REDUCTION

Repair System Description: LP PANEL

Maintenance Agreement Required: ☐ Yes ☑ No

☑ House/Mod. Home No. Bedrooms 4

☐ Mobile Home No. Bathrooms 4

☐ Business No. Employees

☐ Other


☐ Slab ☑ Crawl Space ☐ Basement w/plumbing ☐ Basement wo/plumbing

Water Supply: ☐ Individual ☑ Public ☐ Community

Comments:/Conditions:


Comments:/Conditions:

INITIAL SITE SKETCH 1"=50'

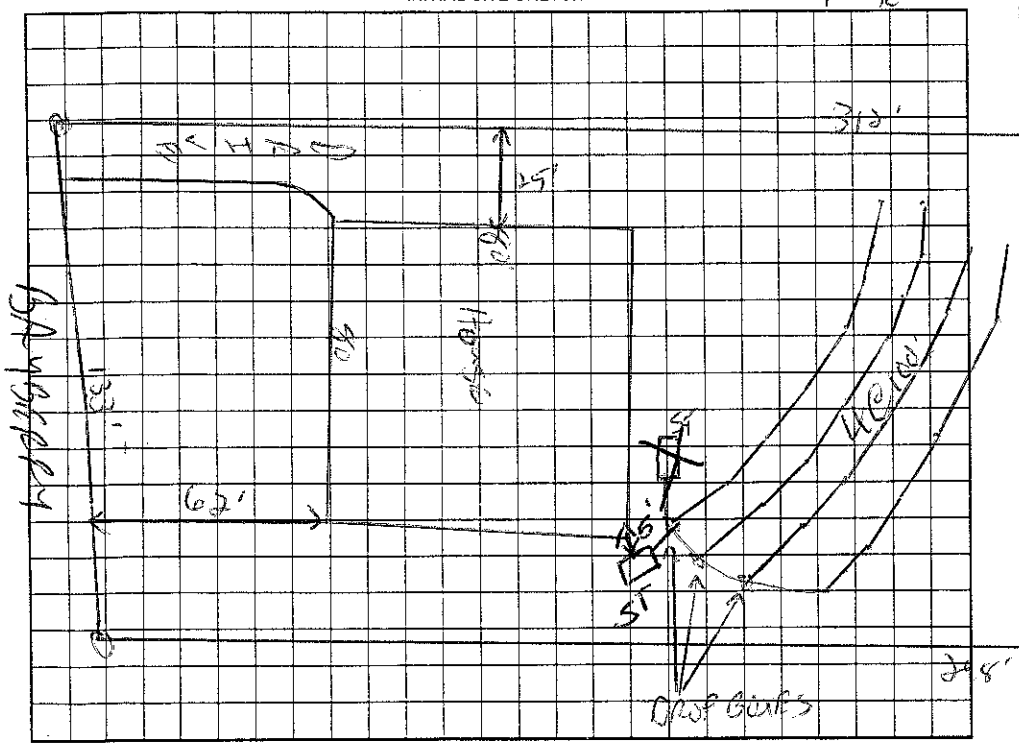

AS BUILT SKETCH

Installed Quick 4 as Drawn used Drop boxes

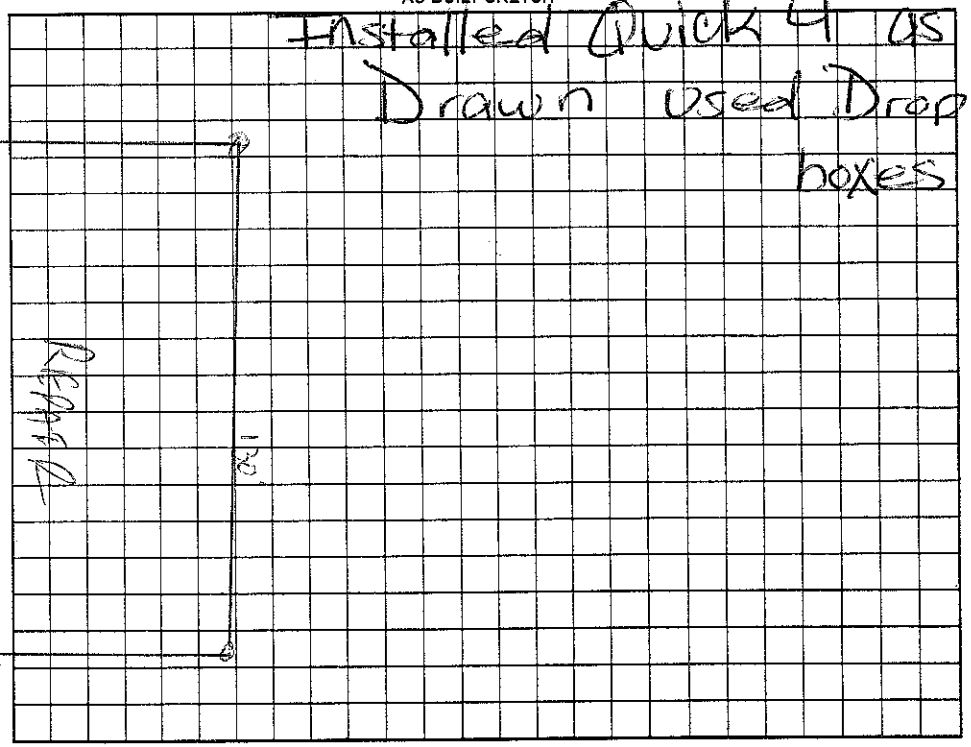

Permit can be suspended or revoked if any false information is supplied toward securing the permit/any unauthorized changes are made to the site/any unauthorized changes are made in the installation of the system. Improvement Permit with plat valid without expiration. Improvement Permit with site plan valid for sixty months. Authorization to Construct is valid for a period equal to that of Improvement Permit – not to exceed sixty months.

Signed: date 2-24-05 Installed by: Richard Abernathy

Improvement Permit by: date 11/23/04 Operation Permit by: date 10/28/05

Authorization to Construct by: Wesley Sparks RS date 6/22/05 Existing System Inspection by: date

HEALTH DEPT. COPY: WHITE OWNER COPY (FINAL): YELLOW OWNER COPY (INITIAL): PINK