IREDELL COUNTY HEALTH DEPARTMENT

STATESVILLE 704-878-5305 MOORESVILLE 704-664-5281

IMPROVEMENT PERMIT / AUTHORIZATION TO CONSTRUCT / OPERATION PERMIT / EXISTING SYSTEM INSPECTION

PERMIT# 1196638 PIN# ~~4625505104.435~~ 4626-28-5785 DATE 6-9-06

OWNER OR APPLICANT L. Shaun Ogden Construction PHONE: Business 309-6810 Home

ADDRESS P.O. Box 1281 Davidson, NC 28036

LOCATION Brawley School Rd TR McKendree TL Bayberry on left

SUBDIVISION The Farms BLOCK / SECTION 3 LOT 435 LOT AREA 1 Acre SITE CLASS PS DESIGN FLOW 600gpd T.A.R. .3

Septic Tank: 1500 Gallons; STB 338 Date 9-30-06
Pump Tank: 1500 Gallons; PT 27 Date 9-26-06
Pump Make: Gould's Model WE512HH Serial No. 9-12-06
Nitrification Field: No Fields 1 Square Feet 1020 Linear Feet 340'
No Lines 5 Trench Width *See note Max Trench Bottom Depth 36" Gravel Depth N/A

☒ New System ☐ Repair ☐ Expansion System Type: I II III IV V VI
System Description: Pump-LP-Panel Block
Repair System Description: Same
Maintenance Agreement Required: ☒ Yes ☐ No

☒ House/Mod. Home ☐ Mobile Home ☐ Business ☐ Other
No. Bedrooms 5 No. Persons ___ No. Employees ___

Water Supply: ☐ Individual ☒ Public ☒ Community


☐ Gravity ☒ Pressure ☐ Slab ☒ Crawl Space ☐ Basement w/plumbing ☐ Basement wo/plumbing

Comments/Conditions: * Note: Trench width as specified in Crescent Communities On Site Sewage Disposal Manual

Comments/Conditions: Must keep Future pool 15ft from Septic System & 10ft from Supply line. Checked Tanks & lines 11/3/06

Scale 1:50'

INITIAL SITE SKETCH

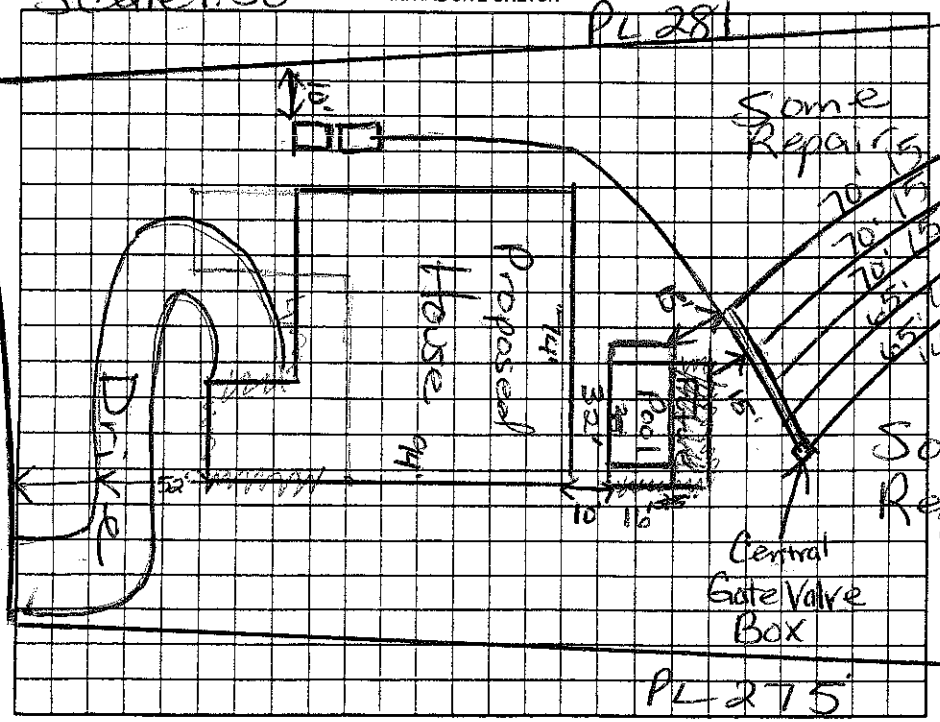

AS BUILT SKETCH

The location of the proposed Pool addition does not appear to impact the existing septic system.

**NOTE:

Amy Melville REHS
Date: 2-25-11
ICHD-Environmental Health Division

Permit can be suspended or revoked if any false information is supplied toward securing the permit/any unauthorized changes are made to the site/any unauthorized changes are made in the installation of the system. Improvement Permit with plat valid without expiration. ☐ Improvement Permit with site plan valid for sixty months ☐ Authorization to Construct is valid for a period equal to that of Improvement Permit – not to exceed sixty months.

Signed: L. Shaun Ogden date 06/13/06 Installed by: Richard Abernathy

Improvement Permit by: Maina M. Dotson RS date 6/9/06 Operation Permit by: Maina M. Dotson RS date 4/20/07

Authorization to Construct by: Maina M. Dotson RS date 6/9/06 Existing System Inspection by: ___ date ___

HEALTH DEPT. COPY: WHITE OWNER COPY (FINAL): YELLOW OWNER COPY (INITIAL): PINK