IREDELL COUNTY HEALTH DEPARTMENT

STATESVILLE 704-878-5305 MOORESVILLE 704-664-5281 P30

IMPROVEMENT PERMIT / AUTHORIZATION TO CONSTRUCT / OPERATION PERMIT / EXISTING SYSTEM INSPECTION

PERMIT# 118600 PIN# ~~4626 36 4001 316~~ 4626286457.000 DATE 11/23/04

OWNER OR CONTRACTOR THE FARMS LLC / SIMONINI BUILDERS PHONE: Business Home

ADDRESS 2214 BRAWLEY SCHOOL RD - MOORESVILLE NC 28115

LOCATION BRAWLEY SCHOOL - TR MCKENDREE - ~~TRANSF~~ - TR BAYBERRY - ONRT

SUBDIVISION THE FARMS BLOCK / SECTION III LOT 316 LOT AREA .934C SITE CLASS RS DESIGN FLOW 450 L.T.A.R. .300/FT2

Septic Tank: 1000 Gallons; STB 338 Date 3-21-06
Pump Tank: 1000 Gallons; PT 21 Date 3-28-06
Pump Make: Goulds Model WE0312M Serial No. B0606723
Nitrification Field: No Fields 1 Square Feet 1200 Linear Feet 400
No Lines 4@100' Trench Width 36" Max Trench Bottom Depth 36" Gravel Depth N/A

☑ New System ☐ Repair System Type: I, II, III, IV, V, VI
System Description: PUMP 27% REDUCTION
Repair System Description: CP PANEL
Maintenance Agreement Required: ☐ Yes ☑ No


☑ House/Mod. Home No. Bedrooms 4
☐ Mobile Home No. Bathrooms 4
☐ Business No. Employees
☐ Other
☐ Slab ☐ Crawl Space ☑ Basement w/plumbing ☐ Basement wo/plumbing

Water Supply: ☐ Individual ☑ Public ☑ Community


Comments/Conditions: ROAD NOT CONSTRUCTED AT TIME OF INSPECTION.
DO NOT CUT HOUSE SITE

Comments/Conditions: 5/4/06 Installed EZ Flow as Drawn
Checked tanks after reset 5/4/06

INITIAL SITE SKETCH 1"=50'

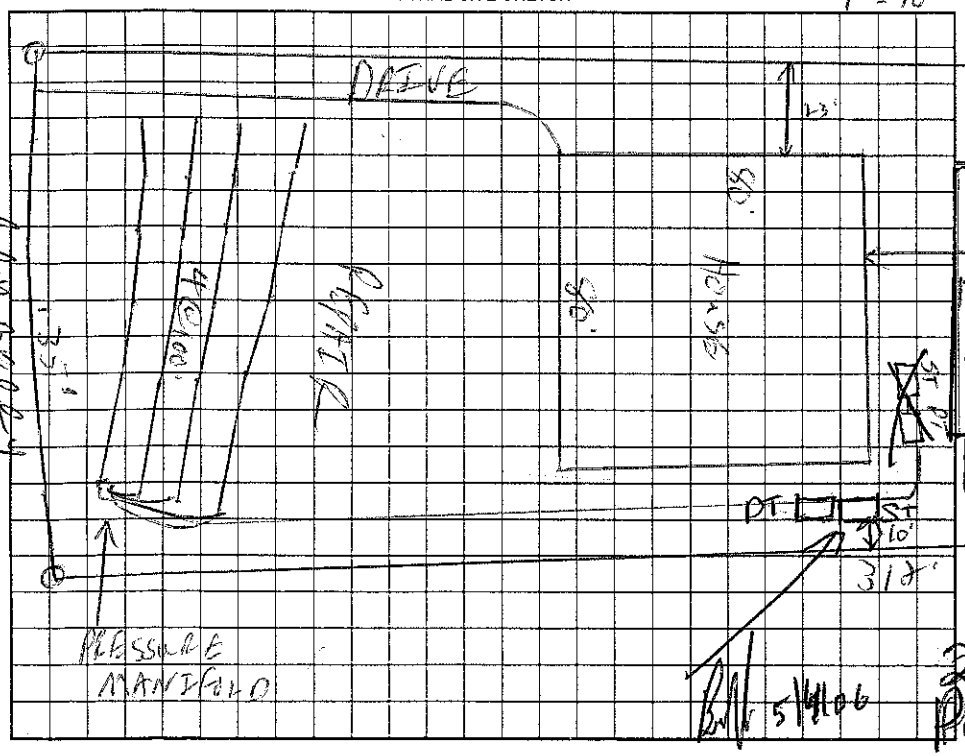

AS BUILT SKETCH

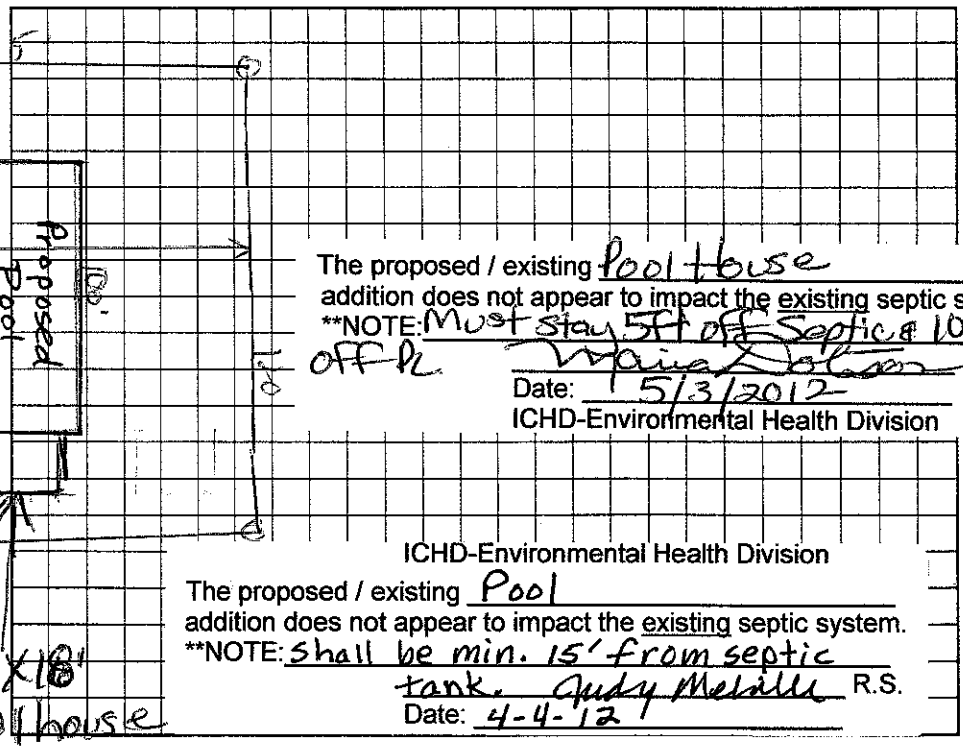

The proposed / existing Pool House addition does not appear to impact the existing septic system
**NOTE: Must stay 5ft off Septic & 10ft off PL
Maria Dolan R.S.
Date: 5/3/2012
ICHD-Environmental Health Division

ICHD-Environmental Health Division
The proposed / existing Pool addition does not appear to impact the existing septic system.
**NOTE: Shall be min. 15' from septic tank. Judy Melillo R.S.
Date: 4-4-12

Permit can be suspended or revoked if any false information is supplied toward securing the permit/any unauthorized changes are made to the site/any unauthorized changes are made in the installation of the system. Improvement Permit with plat valid without expiration. Improvement Permit with site plan valid for sixty months. Authorization to Construct is valid for a period equal to that of Improvement Permit – not to exceed sixty months.

Signed: _____ date 2-24-05 Installed by: R&R

Improvement Permit by: _____ date 11/23/04 Operation Permit by: Maria Dolan RS date 8/28/06

Authorization to Construct by: _____ date 12/21/05 Existing System Inspection by: _____ date _____

HEALTH DEPT. COPY: WHITE OWNER COPY (FINAL): YELLOW OWNER COPY (INITIAL): PINK