# IREDELL COUNTY HEALTH DEPARTMENT

STATESVILLE 704-878-5305 50.00 Paid MOORESVILLE 704-664-5281

## IMPROVEMENT PERMIT / AUTHORIZATION TO CONSTRUCT / OPERATION PERMIT / EXISTING SYSTEM INSPECTION

PERMIT# 118601 PIN# ~~4626387001.317~~ 4626287585.000 DATE 6/27/05

OWNER OR CONTRACTOR Jasper Elders PHONE: Business 704 799-9982 Home

ADDRESS 804 N. Main St Mooresville NC 28115

LOCATION SR, TR McKendree, TL Bayberry, on Rt

SUBDIVISION The Farms BLOCK / SECTION 3 LOT 317 LOT AREA 1.14AC SITE CLASS. PS DESIGN FLOW 600 L.T.A.R. 0.3

Septic Tank: 1500 Gallons; STB 338 Date 10/10/05
Pump Tank: 1500 Gallons; PT Date
Pump Make: Model Serial No.
Nitrification Field: No Fields 1 Square Feet 1500 Linear Feet 500
No Lines 4@125' Trench Width 36" Max Trench Bottom Depth 36" Gravel Depth —

☒ New System ☐ Repair System Type: I, II, (III), IV, V, VI
System Description: PM 25% Reduction
Repair System Description: LP Paul Block
Maintenance Agreement Required: ☐ Yes ☒ No


☒ House/Mod. Home No. Bedrooms 5
☐ Mobile Home No. Bathrooms
☐ Business No. Employees
☐ Other

☐ Slab ☒ Crawl Space ☐ Basement w/plumbing ☐ Basement wo/plumbing

Water Supply: ☐ Individual ☐ Public ☒ ~~Community~~


Comments:/Conditions: 1"=50'

INITIAL SITE SKETCH

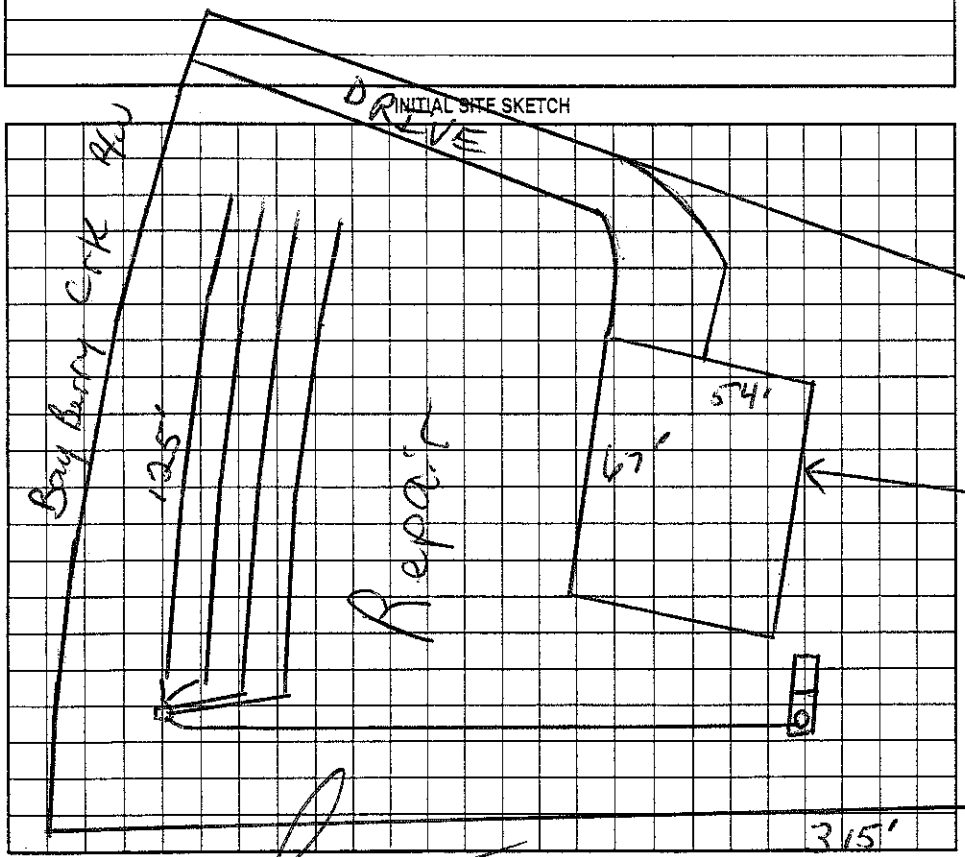


Comments:/Conditions:

AS BUILT SKETCH

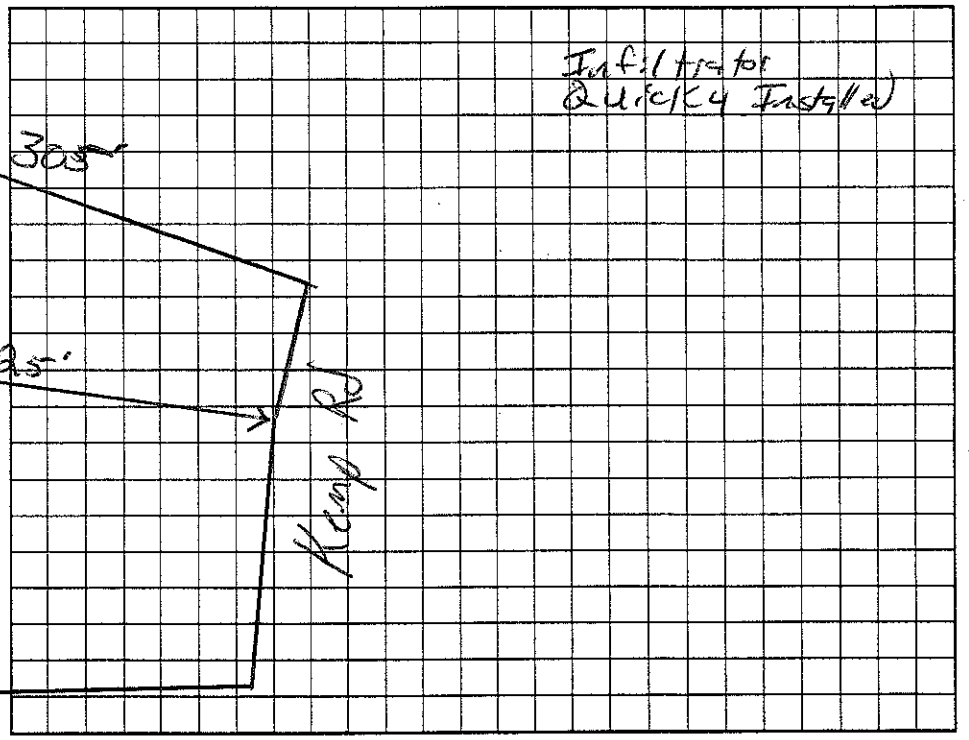


Permit can be suspended or revoked if any false information is supplied toward securing the permit/any unauthorized changes are made to the site/any unauthorized changes are made in the installation of the system. Improvement Permit with plat valid without expiration. Improvement Permit with site plan valid for sixty months. Authorization to Construct is valid for a period equal to that of Improvement Permit – not to exceed sixty months.

Signed: date 6/28/05 Installed by: Abernathy

Improvement Permit by: RS date 4/27/05 Operation Permit by: Wesley Sparkes RS date 4/4/06

Authorization to Construct by: RS date 6/27/05 Existing System Inspection by: date

HEALTH DEPT. COPY: WHITE OWNER COPY (FINAL): YELLOW OWNER COPY (INITIAL): PINK