IREDELL COUNTY HEALTH DEPARTMENT Authorization to Construct

STATESVILLE 704-878-5305 MOORESVILLE 704-664-5281

IMPROVEMENT PERMIT / ~~CERTIFICATE OF COMPLETION~~ / OPERATION PERMIT / EXISTING SYSTEM INSPECTION

PROPERTY DESCRIPTION NO. 068778 DATE 10/27/99 TAX MAP NO. 4626289088 Watershed: X Yes ☐ No

OWNER OR CONTRACTOR Dean E Fisher PHONE: Business _____ Home 483-4269

ADDRESS 2494 Cherry Lane Denver, NC. 28037

LOCATION McKendree Rd. TL Kemp on LT at Century 21 sign - .9 mile on (L) 553 Kemp

SUBDIVISION CL+T BLOCK / SECTION 8 LOT 1633 LOT AREA 2.167AC SITE CLASS. PS DESIGN FLOW 360 L.T.A.R. 1.3

Septic Tank: 1000 Gallons; STB 312 Date 7-23-00

Pump Tank: 1000 Gallons; PT 27 Date 6-27-00

Pump Make: Goulds Model WE05511H Serial No. [illegible]

Nitrification Field: No Fields 1 Square Feet 900 Linear Feet 360

No Lines 3 Trench Width 36" Max Trench Bottom Depth 36" Gravel Depth SAND

X New System ☐ Repair System Type: I, II, III, IV, V, VI

System Description: PressMAN-CH PLASTIC

Repair System Description: SAME MATERIAL

Maintenance Agreement Required: ☐ Yes ☐ No

X House/Mod. Home No. Bedrooms 3

☐ Mobile Home No. Bathrooms 3

☐ Business No. Employees ____

☐ Other ____


☐ Slab ☐ Crawl Space X Basement w/plumbing ☐ Basement wo/plumbing

Water Supply: X Individual ☐ Community ☐ Public


Comments:

Comments: Filter & riser installed
Tanks & lines checked 8/30/00 MD
Pressure Checked 8/31/00

INITIAL SITE SKETCH

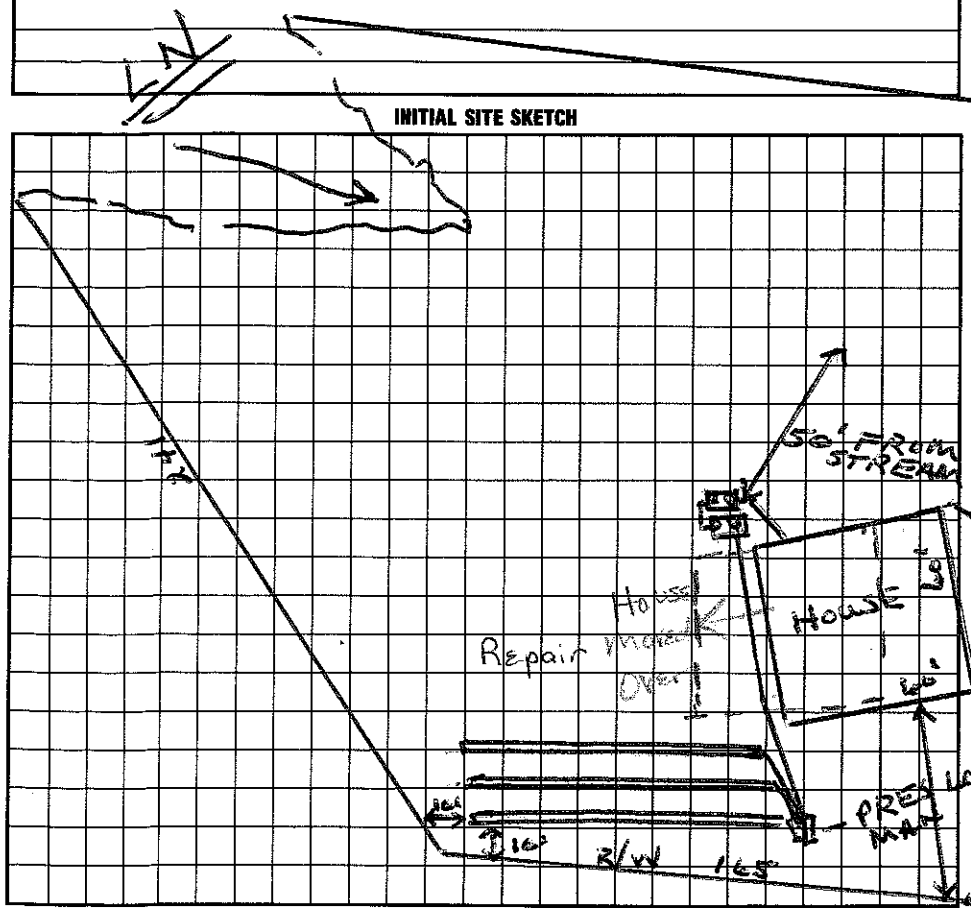

AS BUILT SKETCH

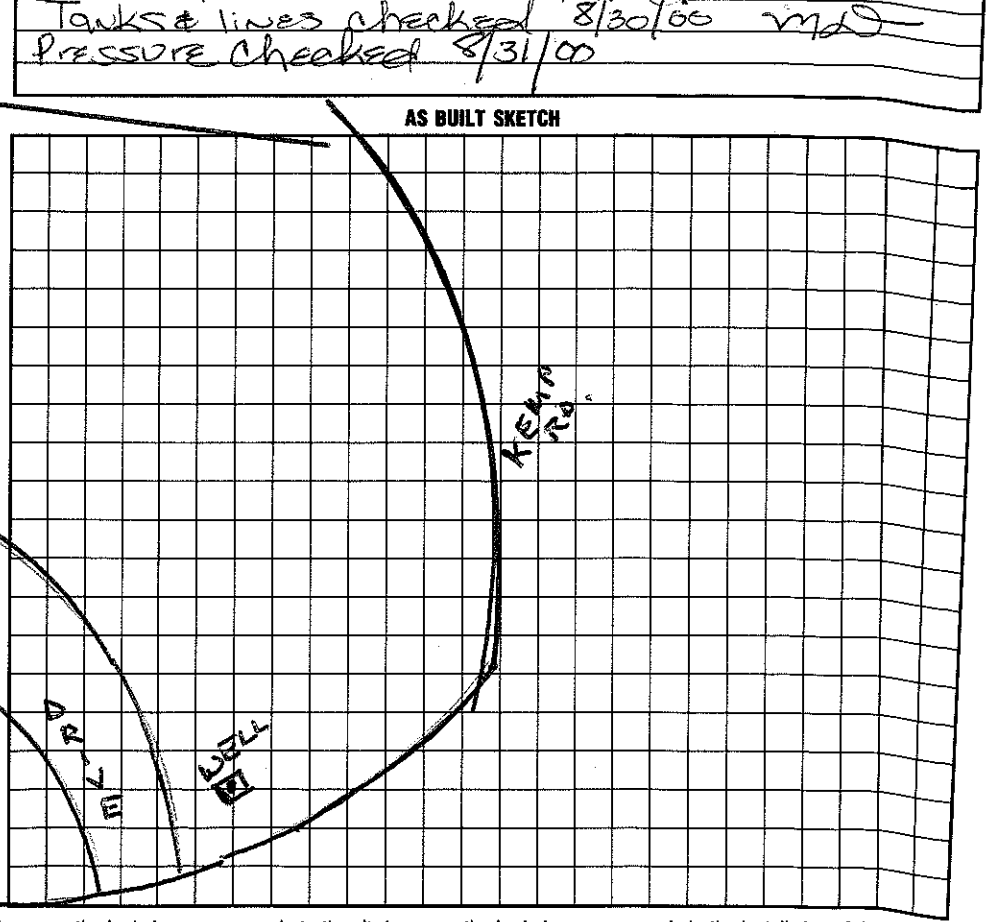

I understand that this permit can be suspended or revoked if any false information is supplied toward securing the permit/any unauthorized changes are made to the site/any unauthorized changes are made in the installation of the system. Improvement Permit is valid for 60 months from date of issuance.

Signed: * Kemp Rd.

Improvement Permit by: Wesley Sparks RS. date 10/27/99

Existing System Inspection by: Wesley Sparks RS. date 10/27/99

Installed by: Atlantic Grading

Certificate of Completion by: Maria H. Dotson RS. date 10/3/2000

Operation Permit by: _____ date _____

HEALTH DEPT. COPY: WHITE INSPECTION COPY (FINAL): GREEN OWNER COPY (FINAL): YELLOW INSPECTION COPY (INITIAL): PINK OWNER COPY (INITIAL): GOLD