IREDELL COUNTY HEALTH DEPARTMENT - *ENVIRONMENTAL HEALTH* ☐ STATESVILLE OFFICE 704-878-5305 ☐ MOORESVILLE OFFICE 704-664-5281

IMPROVEMENT PERMIT / AUTHORIZATION TO CONSTRUCT / OPERATION PERMIT / EXISTING SYSTEM INSPECTION

PERMIT # PIN # 4626289896 Majestic DATE 2-28-2012

OWNER Daniel Coffman APPLICANT: Jacob Marchpool PHONE: Home/Cell # 404 429 9753 Business #

SITE ADDRESS 195 Bayberry Creek Circle OWNER / APPLICANT ADDRESS Majestic Pool 1162 Ft. Mill Hwy Fort Mill, SC 29707

SITE DIRECTIONS Brawley School Rd TR McKendree TL Bayberry on left #195

SUBDIVISION The Farms BLOCK / SECTION 3 LOT # 432 LOT AREA 1.13 ac DESIGN FLOW 480gpd L.T.A.R. e3


Existing

Septic Tank 1500	Gallons: STB	Date	☐ New System ☐ Repair ☐ Expansion System Type I II III IV V VI	☒ Residence	No. Bedrooms 4	Water Supply
Pump Tank 1000	Gallons: P T	Date	System Description: Pump - 25% Reduction	☐ Business	No. Persons	☐ Private
Pump Make	Model	Serial #	Repair System Description: Pump in Panel BTK	☒ Other Pool House	No. Employees	☒ Public
No. Nitrification Fields: 1	No. Lines 4	Linear Feet 400	Maintenance Agreement Required ☐ YES ☒ NO	☐ Slab	☒ Crawl Space	☒ Community
Trench Width 36"	Max. Trench Bottom Depth 36"	Gravel Depth N/A	☐ GRAVITY ☒ PRESSURE	☐ Basement w/plumbing	☐ Basement w/o plumbing	


Comments / Conditions: Existing Septic System appears to be Functioning okay AT time of inspection. OK to gravity Feed New Supply line into ST

Must keep Building Footers at least 5FT from Septic System including "Repair Area" No Cut greater than 2FT within 15FT of Repair Area. Keep New Supply line at least 10 F

INITIAL SITE SKETCH

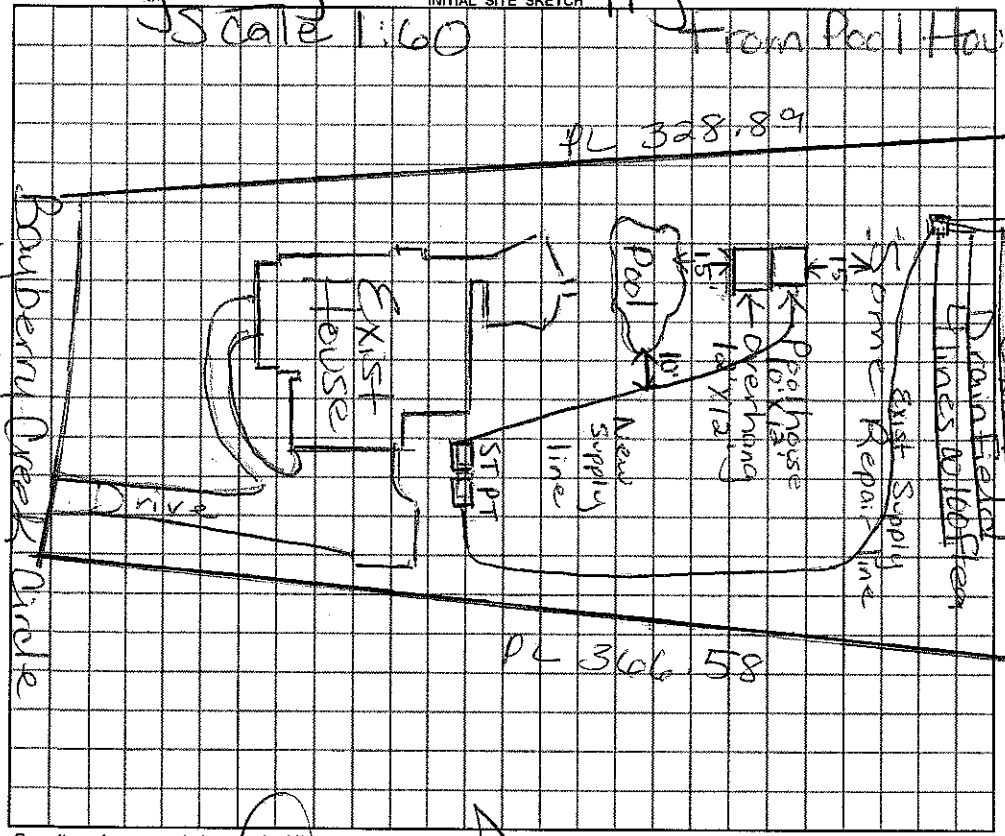

AS BUILT SKETCH

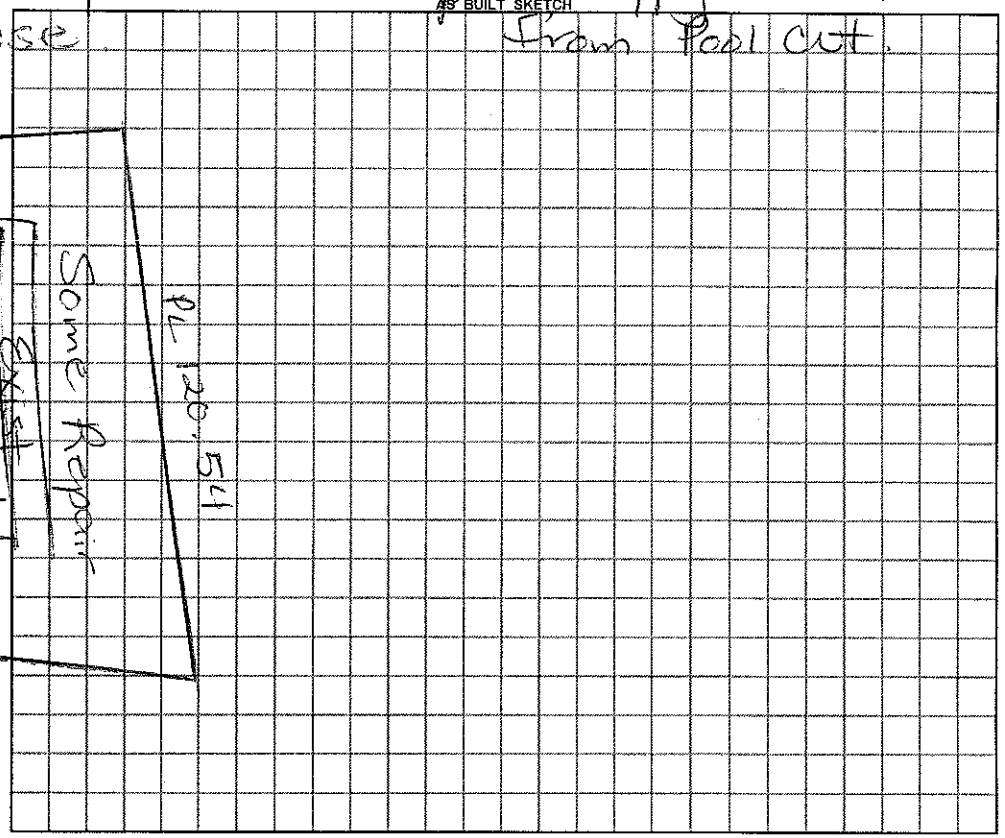

Permit can be suspended or revoked if any false information is supplied toward securing the permit / any unauthorized changes are made to the site / any unauthorized changes are made in the installation of the system.

☐ ***IMPROVEMENT PERMIT*** with plat valid without expiration ☐ ***IMPROVEMENT PERMIT*** with plat valid without expiration, site plan valid 60 mo. ☐ ***AUTHORIZATION TO CONSTRUCT*** valid for period equal to IMPROVEMENT PERMIT—not to exceed 60 mo.

Owner / Applicant Signature: Date 02/29/2012 Installed by:

IMPROVEMENT PERMIT by: REHS Date

AUTHORIZATION TO CONSTRUCT by: REHS Date

OPERATION PERMIT by: REHS Date

Existing System Inspected by: REHS Date 2/28/2012

YOU SHOULD CONTACT A LOCATOR SERVICE PRIOR TO ANY EXCAVATION

White Copy – Environmental Health YELLOW COPY (Final) Owner / Applicant PINK COPY (Initial) Owner / Applicant