450.00 Paid 3:30

IREDELL COUNTY HEALTH DEPARTMENT

STATESVILLE 704-878-5305 MOORESVILLE 704-664-5281

IMPROVEMENT PERMIT / AUTHORIZATION TO CONSTRUCT / OPERATION PERMIT / EXISTING SYSTEM INSPECTION

PERMIT# 131298 PIN# 4626.07 1828.491 4626-29-0431 DATE 4-18-06

OWNER OR APPLICANT Jasper Builders PHONE: Business 799-9982 Home

ADDRESS 804 N. Main St Mooresville, NC 28115

LOCATION Brawley School Rd TR McKendree TR onto Bare Foot Ln TR E Cold Hollow Farm Dr at end on left

SUBDIVISION The Farms BLOCK / SECTION 4 LOT 491 LOT AREA .795 Acre SITE CLASS. PS DESIGN FLOW 600gpd L.T.A.R. .25-.3

Septic Tank: 1500 Gallons; STB 338 Date 8-22-06

Pump Tank: 1500 Gallons; PT 477 Date 8-25-06

Pump Make: Model Serial No.

Nitrification Field: No Fields 1 Square Feet 1020 Linear Feet 340'

No Lines 4 Trench Width X See Rule Max Trench Bottom Depth 36"

X New System ☐ Repair ☐ Expansion System Type: I II III IV V VI

System Description: Pump-Lp-Panel Block

Repair System Description: Same

Maintenance Agreement Required: X Yes ☐ No

Gravel Depth N/A ☐ Gravity ☐ Pressure

X House/Mod. Home No. Bedrooms 5

☐ Mobile Home No. Persons

☐ Business No. Employees

☐ Other

Water Supply: ☐ Individual X Public X Community


☐ Slab ☐ Crawl Space ☐ Basement w/plumbing ☐ Basement wo/plumbing

Comments/Conditions: Note: Use trench width as specified in Crescent Communities Handbook

Comments/Conditions:

Scale 1:50

INITIAL SITE SKETCH

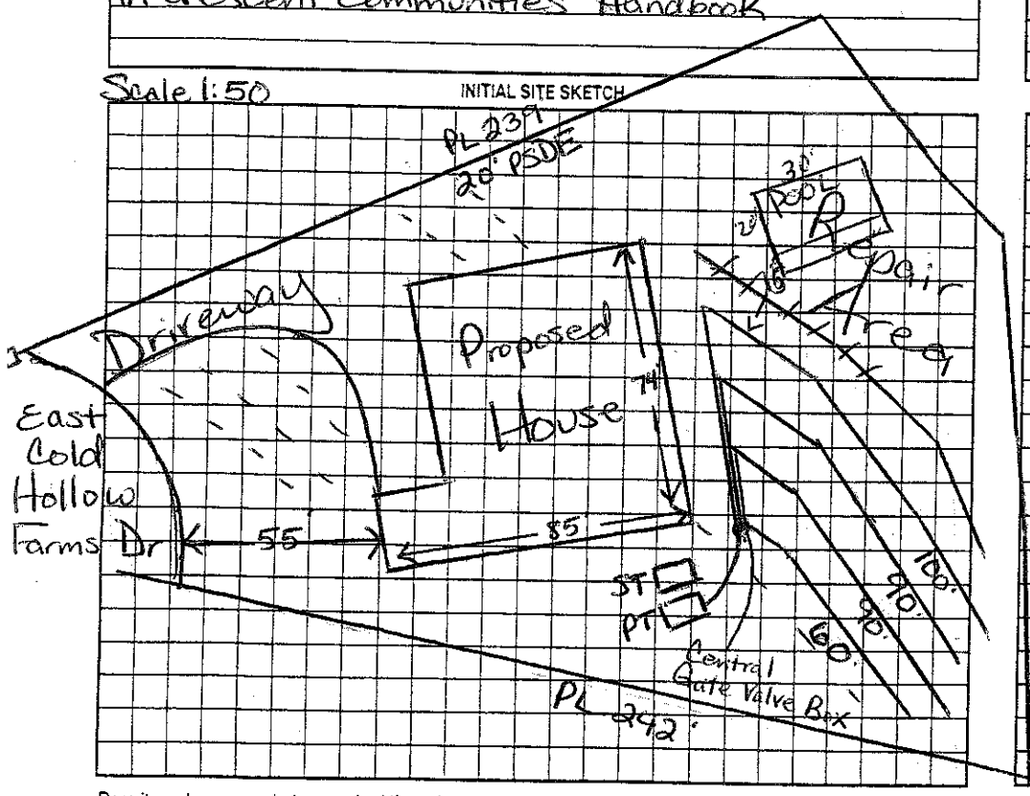

AS BUILT SKETCH

- TANKS CHECKED
- LINES CHECKED

POOL SITE APPROVED
5-10-07 John E' Alph
per site plan by Gary McNeely
- moved repair area throughout yard

The proposed / existing Bedroom & Playroom addition does not appear to impact the existing septic system.

**NOTE: Total # bedrooms ~~=~~ to 5, can not exceed 5

Date: 8/10/12 OK to add Upset 11/30/12 mD

ICHD-Environmental Health Division R.S.

Permit can be suspended or revoked if any false information is supplied toward securing the permit/any unauthorized changes are made to the site/any unauthorized changes are made in the installation of the system. Improvement Permit with plat valid without expiration. ☐ Improvement Permit with site plan valid for sixty months ☐ Authorization to Construct is valid for a period equal to that of Improvement Permit – not to exceed sixty months.

Signed: Jerri Crawley date 4-24-06 Installed by: Abernathy

Improvement Permit by: Maria H. Dolson RS date 4/18/06 Operation Permit by: John E' Alph date 12/19/06

Authorization to Construct by: Maria H. Dolson RS date 4/18/06 Existing System Inspection by: date

HEALTH DEPT. COPY: WHITE OWNER COPY (FINAL): YELLOW OWNER COPY (INITIAL): PINK