IREDELL COUNTY HEALTH DEPARTMENT

STATESVILLE 704-878-5305 MOORESVILLE 704-664-5281

IMPROVEMENT PERMIT / AUTHORIZATION TO CONSTRUCT / OPERATION PERMIT / EXISTING SYSTEM INSPECTION

PERMIT# 131306 PIN# 4626607828.495 4626-29-1037 DATE 8-31-06

OWNER OR APPLICANT T. Whalen Homes PHONE: Business 662-6466 Home 400-8932

ADDRESS P.O. Box 4419 Mooresville, NC 28117

LOCATION Brawley School Rd TR McKendree TR Bare Foot Ln TR East Cold Hollow Farms Dr on right near end

SUBDIVISION The Farms BLOCK / SECTION 4 LOT 495 LOT AREA 1.284 Acre SITE CLASS. PS DESIGN FLOW 600 gpd L.T.A.R. .3

Septic Tank: 1500 Gallons; STB 338 Date 7-2-06
Pump Tank: 1500 Gallons; PT 477 Date 3-17-06
Pump Make: Goulds Model WE0724 Serial No.
Nitrification Field: No Fields 1 Square Feet 1008 Linear Feet 336'
No Lines 30 12' Trench Width *See Note Max Trench Bottom Depth 36" Gravel Depth N/A

☒ New System ☐ Repair ☐ Expansion System Type: I II III IV V VI
System Description: Pump-LP- Panel Block
Repair System Description: Same
Maintenance Agreement Required: ☒ Yes ☐ No

☒ House/Mod. Home No. Bedrooms 5
☐ Mobile Home No. Persons
☐ Business No. Employees
☐ Other


Water Supply: ☐ Individual ☒ Public ☒ Community

☐ Gravity ☒ Pressure ☐ Slab ☒ Crawl Space ☐ Basement w/plumbing ☐ Basement wo/plumbing

Comments:/Conditions: *Note: Use trench width as specified in Crescent Communities On Site Wastewater Manual PL-351

Comments:/Conditions: Must keep future pool at least 15Ft from Septic System Tanks, lines & pressure. Checked 9/15/06

INITIAL SITE SKETCH

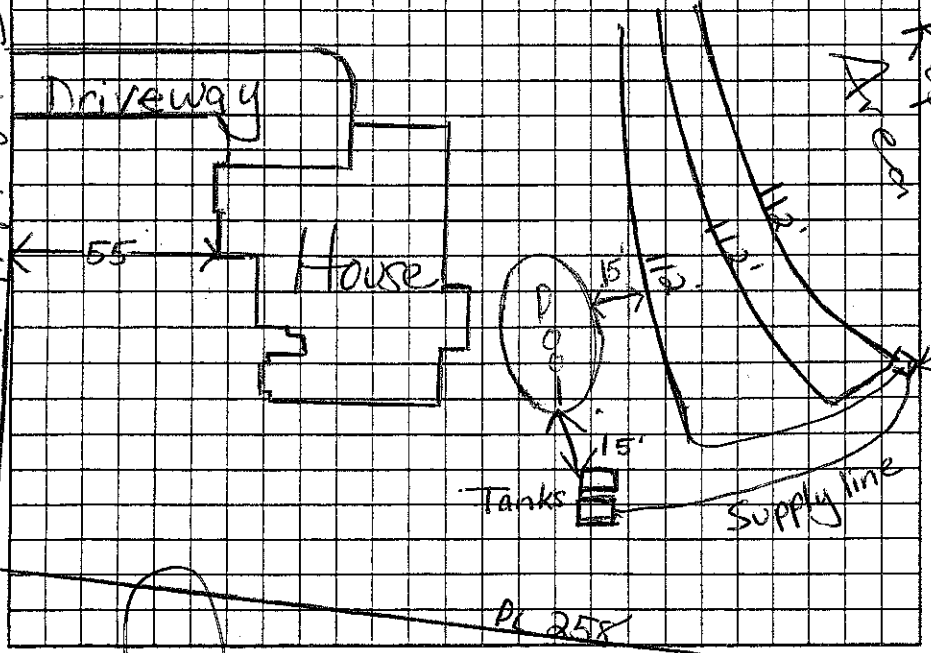

AS BUILT SKETCH

Installed as Drawn
25 panels per stitch
3/16" hole, 3Ft head

Permit can be suspended or revoked if any false information is supplied toward securing the permit/any unauthorized changes are made to the site/any unauthorized changes are made in the installation of the system. Improvement Permit with plat valid without expiration ☐ Improvement Permit with site plan valid for sixty months ☐ Authorization to Construct is valid for a period equal to that of Improvement Permit – not to exceed sixty months.

Signed: date

Improvement Permit by: Maria H. Dotson RS date 8/31/06

Authorization to Construct by: Maria H. Dotson RS date 8/31/06

Installed by: Orbison RS

Operation Permit by: Maria H. Dotson date 10/5/06

Existing System Inspection by: date

HEALTH DEPT. COPY: WHITE OWNER COPY (FINAL): YELLOW OWNER COPY (INITIAL): PINK