IREDELL COUNTY HEALTH DEPARTMENT

4626295579 (1:30 / 2:00)

STATESVILLE 704-878-5305 MOORESVILLE 704-664-5281

IMPROVEMENT PERMIT / AUTHORIZATION TO CONSTRUCT / OPERATION PERMIT / EXISTING SYSTEM INSPECTION

PERMIT# 92435 PIN# [redacted] PT 4626 99 2962 DATE 11/6/00

OWNER OR CONTRACTOR EASTER DEV. / LEWIS CARPENTER PHONE: Business 664-2906 Home

ADDRESS 227 HIDEAWAY LN. MOORESVILLE NC 28117

LOCATION BRAWLEY SCHOOL - TR MCKENDREE - TR LAKEVIEW - ON RT

SUBDIVISION BLACKBERRY CREEK BLOCK / SECTION II LOT 1 LOT AREA .75AC SITE CLASS. DS DESIGN FLOW 300GPD L.T.A.R. 3gpd/ft²

ENTERED

Septic Tank: 1000 Gallons; STB 794 Date 2/14/01

Pump Tank: Gallons; PT Date

Pump Make: Model Serial No.

Nitrification Field: No Fields 1 Square Feet 900 Linear Feet 300

No Lines 4@75' Trench Width 36" Max Trench Bottom Depth 36" Gravel Depth N/A

☑ New System ☐ Repair System Type: I, II, (III), IV, V, VI

System Description: GRAVITY 25% REDUCTION

Repair System Description: GRAVITY PANEL

Maintenance Agreement Required: ☐ Yes ☑ No

☑ House/Mod. Home No. Bedrooms 3

☐ Mobile Home No. Bathrooms 3

☐ Business No. Employees

☐ Other


☐ Slab ☑ Crawl Space ☐ Basement w/plumbing ☐ Basement wo/plumbing

Water Supply: ☑ Individual ☐ Public ☐ Community


Comments:/Conditions: 1) KEEP WELL 50' FROM SEPTIC SYSTEM. 2) GULLEY TO BE FILLED PROPERLY 3) REMOVE TERRACES AND BERMS

Comments:/Conditions: 1) TANK ON OTHER SIDE OF HOUSE - APPROVED CBF

INITIAL SITE SKETCH 1"=50'

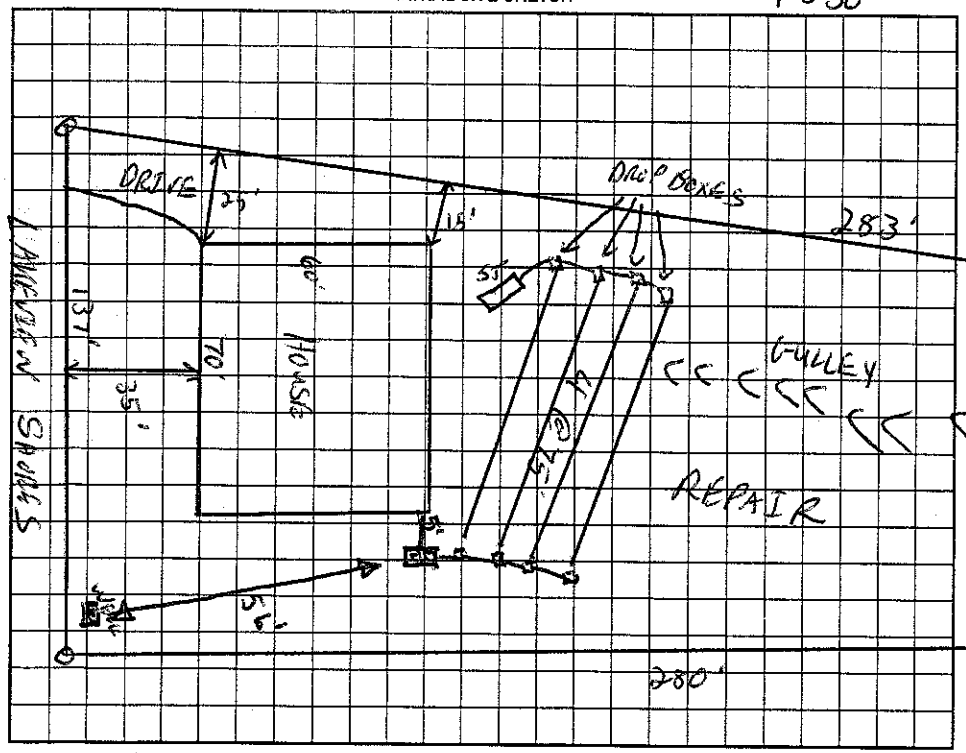

AS BUILT SKETCH

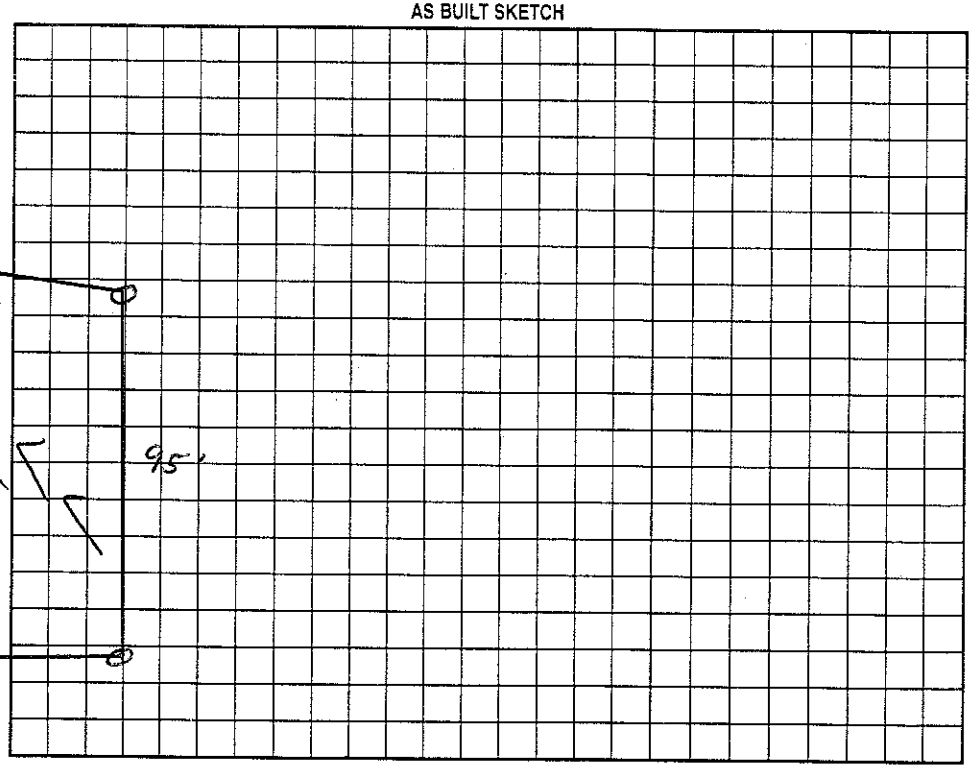

Permit can be suspended or revoked if any false information is supplied toward securing the permit/any unauthorized changes are made to the site/any unauthorized changes are made in the installation of the system. Improvement Permit with plat valid without expiration. Improvement Permit with site plan valid for sixty months. Authorization to Construct is valid for a period equal to that of Improvement Permit – not to exceed sixty months.

Signed: [signature] PRES date 11-9-06

Improvement Permit by: [signature] RS date 11/6/00

Authorization to Construct by: [signature] RS date 5/2/00

Installed by: Larry Beam

Operation Permit by: Wesley Sparkes date 7/12/01

Existing System Inspection by: date

HEALTH DEPT. COPY: WHITE OWNER COPY (FINAL): YELLOW OWNER COPY (INITIAL): PINK