IREDELL COUNTY HEALTH DEPARTMENT

STATESVILLE 704-878-5305 MOORESVILLE 704-664-5281

IMPROVEMENT PERMIT / AUTHORIZATION TO CONSTRUCT / OPERATION PERMIT / EXISTING SYSTEM INSPECTION

PERMIT# 092443 PIN# ~~4626 46 26 38 7480 PT~~ 4626-29-6193 DATE 9-25-00

OWNER OR CONTRACTOR EASTER DEVELOP. CORP/Hans Carpenter PHONE: Business 664-2906 Home

ADDRESS 227 Hideaway LN Mooresville NC 28117

LOCATION Brawley School R McKendree, R. Lakeview Dr - ON CORNER

SUBDIVISION Blackberry Creek II BLOCK / SECTION II LOT 5 LOT AREA .71 acre SITE CLASS. PS DESIGN FLOW 360GPD L.T.A.R. .35 gpd/ft²

Septic Tank: 1000 Gallons; STB Date

Pump Tank: Gallons; PT Date

Pump Make: Model Serial No.

Nitrification Field: No Fields 1 Square Feet 1035 Linear Feet 345

No Lines 3@115' Trench Width 36" Max Trench Bottom Depth 24" Gravel Depth 12"

☒ New System ☐ Repair System Type: I, II, III, IV, V, VI

System Description: GRAVITY CONVENTIONAL

Repair System Description: GRAVITY/PUMP 25% REDUCTION

Maintenance Agreement Required: ☐ Yes ☒ No

☒ House/Mod. Home No. Bedrooms 3

☐ Mobile Home No. Bathrooms 2½

☐ Business No. Employees

☐ Other

☐ Slab ☑ Crawl Space ☐ Basement w/plumbing ☐ Basement wo/plumbing


Water Supply: ☒ Individual ☐ Public ☐ Community

Comments:/Conditions: 1) REMOVE TERRACES AND BERMS


12-15-00 Floor plan reviewed; appears in compliance with L.P. House to be located where shown. DRH

Comments:/Conditions:

INITIAL SITE SKETCH 1" = 50'

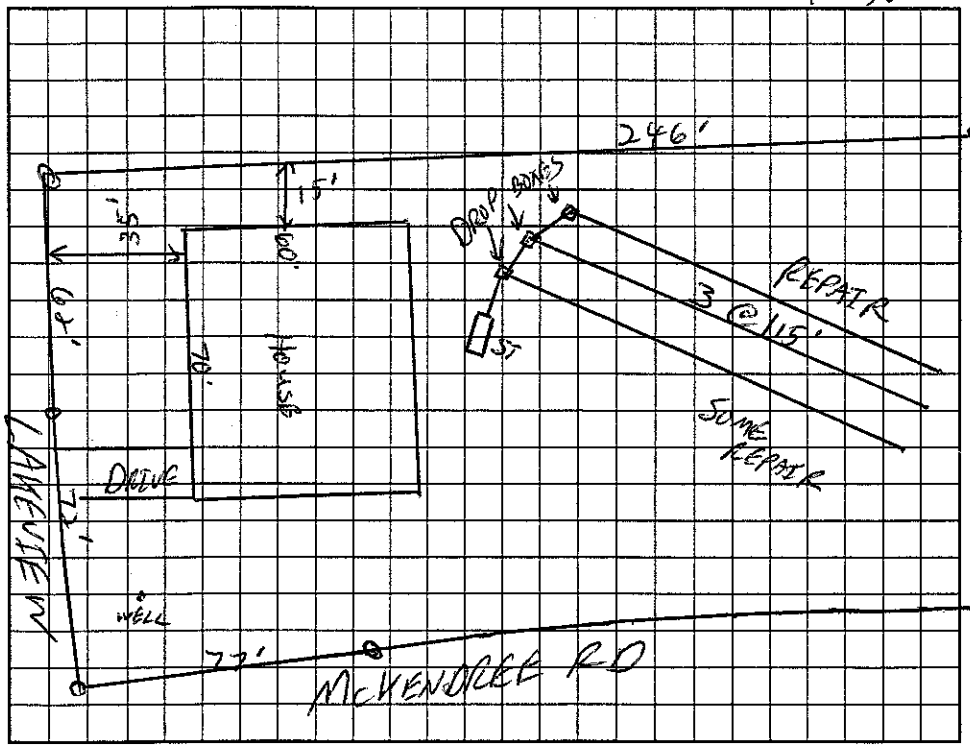

AS BUILT SKETCH

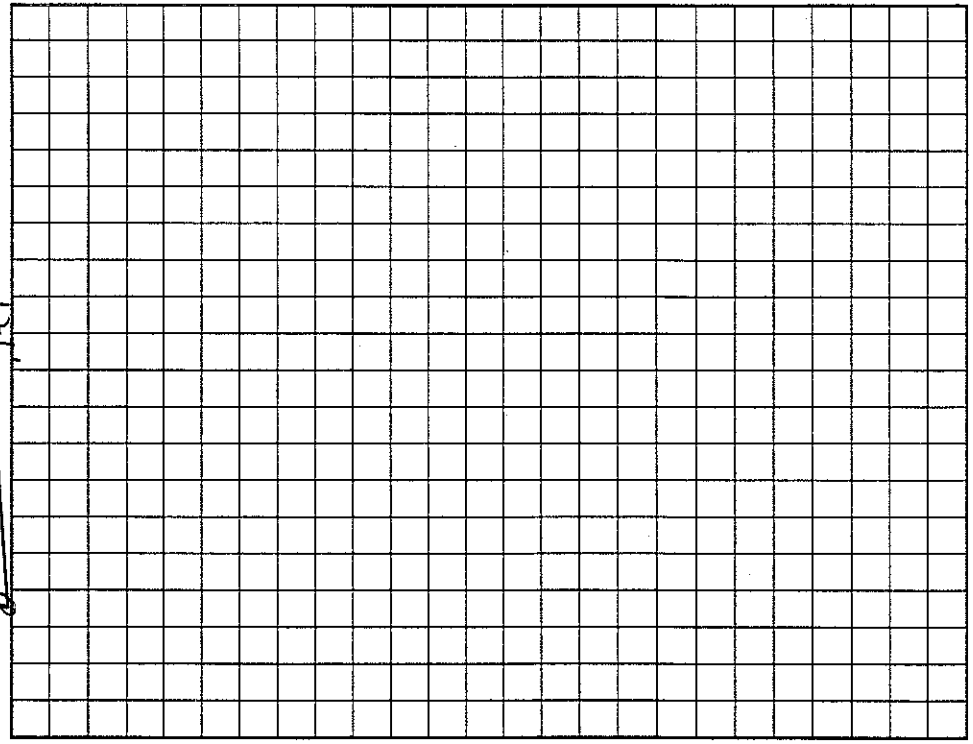

Permit can be suspended or revoked if any false information is supplied toward securing the permit/any unauthorized changes are made to the site/any unauthorized changes are made in the installation of the system. Improvement Permit with plat valid without expiration. Improvement Permit with site plan valid for sixty months. Authorization to Construct is valid for a period equal to that of Improvement Permit – not to exceed sixty months.

Signed: date 9-25-00

Improvement Permit by: RS date 11/7/00

Authorization to Construct by: RS date 12/15/00

Installed by: Larry Boam

Operation Permit by: RS date 5/23/01

Existing System Inspection by: date

HEALTH DEPT. COPY: WHITE OWNER COPY (FINAL): YELLOW OWNER COPY (INITIAL): PINK