IREDELL COUNTY HEALTH DEPARTMENT

STATESVILLE 704-878-5305 50.00 Paid 1338 MOORESVILLE 704-664-5281

IMPROVEMENT PERMIT / AUTHORIZATION TO CONSTRUCT / OPERATION PERMIT / EXISTING SYSTEM INSPECTION

PERMIT# 092441 PIN# ~~4626387480 PT~~ 4626-29-6266 DATE 4-3-2001

OWNER OR CONTRACTOR Lewis Carpenter PHONE: Business M 634-5183 Home

ADDRESS P.O. Box 690027 Charlotte, NC 28227

LOCATION Brawley School Rd TR McKendree TR Lakeview Dr. ON Rt. (2nd lot in)

SUBDIVISION Blackberry Creek BLOCK / SECTION II LOT 4 LOT AREA .73 Acres SITE CLASS. PS DESIGN FLOW 360gpd L.T.A.R. .3

Septic Tank: 1000 Gallons; STB 794 Date 3/29/01
Pump Tank: ____ Gallons; PT ____ Date ____
Pump Make: ____ Model ____ Serial No. ____
Nitrification Field: No Fields 1 Square Feet 900' Linear Feet 300'
No Lines 3 at 100' Trench Width 36" Max Trench Bottom Depth 36" Gravel Depth N/A

[X] New System [ ] Repair System Type: I, II, (III), IV, V, VI
System Description: Gravity-25% Reduction
Repair System Description: Pump - Panel
Maintenance Agreement Required: [ ] Yes [X] No


[X] House/Mod. Home No. Bedrooms 3
[ ] Mobile Home No. Bathrooms 2
[ ] Business No. Employees ____
[ ] Other ____
[ ] Slab [X] Crawl Space [ ] Basement w/plumbing [ ] Basement wo/plumbing

Water Supply: [X] Individual [ ] Public [ ] Community

Comments:/Conditions: Keep Septic System at least 10' From PL & 50' From any Well. Keep well at least 25' From House & 50' from any part of Septic System.

Comments:/Conditions: CH Plastic shielded

INITIAL SITE SKETCH Scale 1:50'

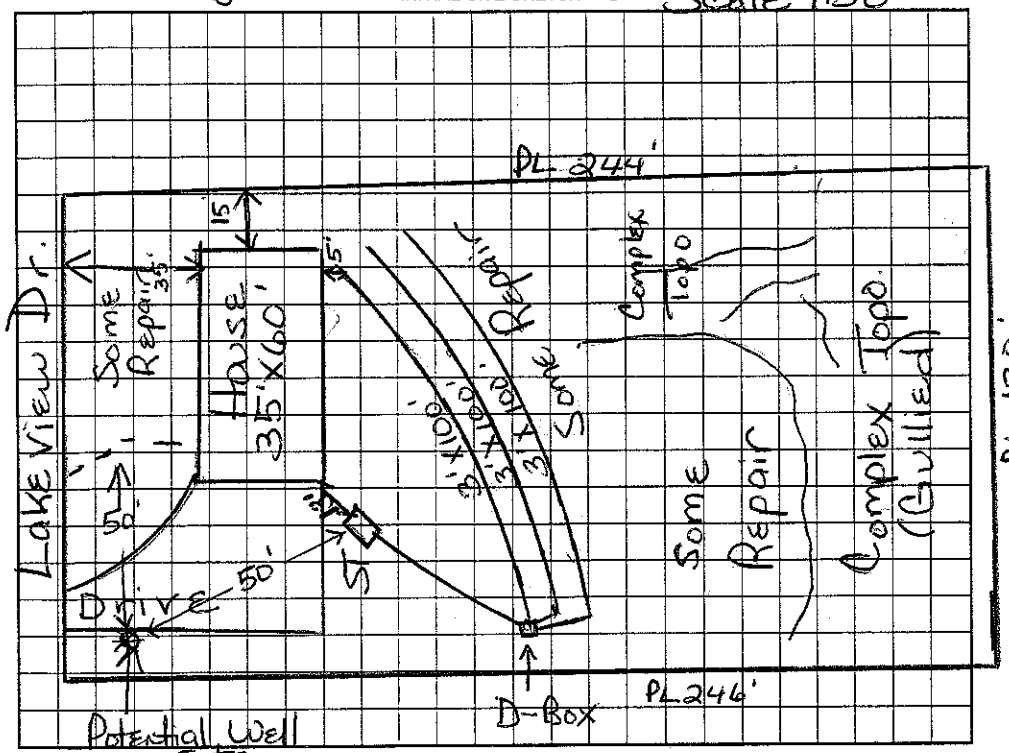

AS BUILT SKETCH

Permit can be suspended or revoked if any false information is supplied toward securing the permit/any unauthorized changes are made to the site/any unauthorized changes are made in the installation of the system. Improvement Permit with plat valid without expiration. Improvement Permit with site plan valid for sixty months. Authorization to Construct is valid for a period equal to that of Improvement Permit – not to exceed sixty months.

Signed: [signature] date 4-9-01 Installed by: Larry Beam.

Improvement Permit by: Maria H.H. Dotson RS date 4/4/2001 Operation Permit by: Wesley Sparks RS. date 7/19/01

Authorization to Construct by: Maria H.H. Dotson R.S. date 4/4/2001 Existing System Inspection by: ____ date ____

HEALTH DEPT. COPY: WHITE OWNER COPY (FINAL): YELLOW OWNER COPY (INITIAL): PINK

IREDELL COUNTY HEALTH DEPARTMENT

STATESVILLE 704-878-5305 MOORESVILLE 704-664-5281

IMPROVEMENT PERMIT / AUTHORIZATION TO CONSTRUCT / OPERATION PERMIT / EXISTING SYSTEM INSPECTION

PERMIT# 092441 PIN# 4626 38 7480 PT DATE 9-25-00

OWNER OR CONTRACTOR EASTER DEVELOP. CORP PHONE: Business 664-2906 Home

ADDRESS 227 Hide Away Ln Mooresville NC 28117

LOCATION Brawley School, R McKendree, R Lakeview Dr. - ON RT

SUBDIVISION Blackberry Creek II BLOCK / SECTION II LOT 4 LOT AREA .73 acre SITE CLASS. PS DESIGN FLOW 360GPD L.T.A.R. .30PD/FT²

Septic Tank: 1000 Gallons; STB Date

Pump Tank: 1000 Gallons; PT Date

Pump Make: Model Serial No.

Nitrification Field: No Fields 1 Square Feet 1200 Linear Feet 400

No Lines 4@100' Trench Width 36" Max Trench Bottom Depth 36" Gravel Depth 12"

☒ New System ☐ Repair System Type: I, II, III, IV, V, VI

System Description: PUMP CONVENTIONAL

Repair System Description: PUMP PANEL

Maintenance Agreement Required: ☐ Yes ☒ No

☒ House/Mod. Home ☐ Mobile Home ☐ Business ☐ Other

No. Bedrooms 3 No. Bathrooms 2½ No. Employees


☐ Slab ☐ Crawl Space ☒ Basement w/plumbing ☐ Basement wo/plumbing

Water Supply: ☒ Individual ☐ Public ☐ Community


Comments:/Conditions: 1) KEEP WELL 50' FROM TANKS AND LINES. 2) REMOVE TERRACES AND BERMS

Comments:/Conditions:

INITIAL SITE SKETCH 1" = 50'

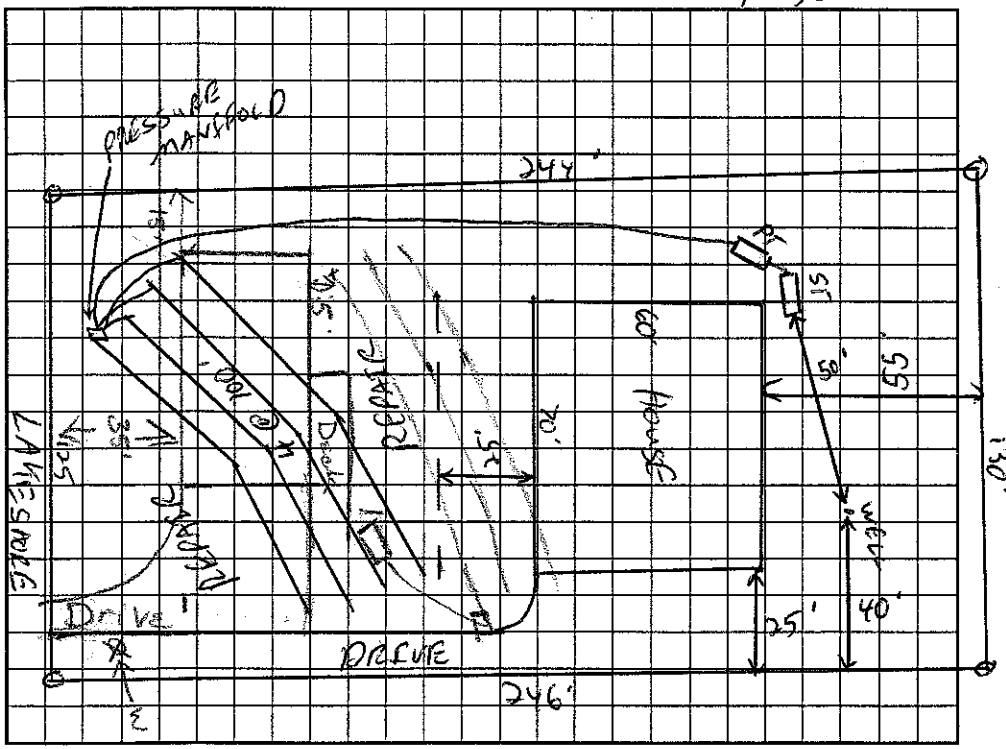

AS BUILT SKETCH

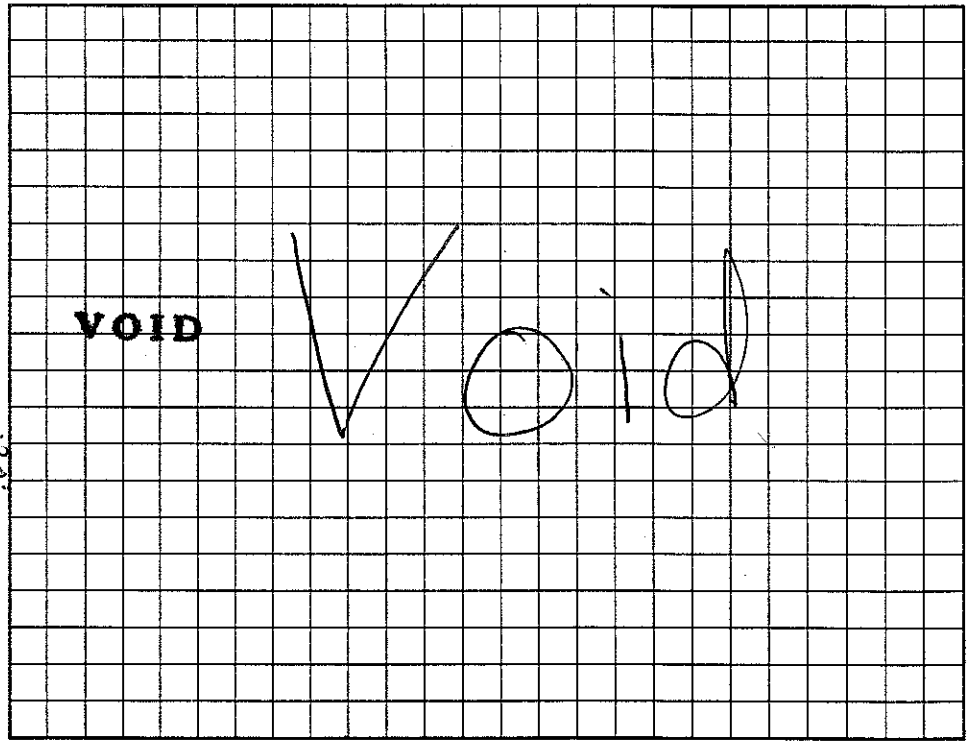

Permit can be suspended or revoked if any false information is supplied toward securing the permit/any unauthorized changes are made to the site/any unauthorized changes are made in the installation of the system. Improvement Permit with plat valid without expiration. Improvement Permit with site plan valid for sixty months. Authorization to Construct is valid for a period equal to that of Improvement Permit – not to exceed sixty months.

Signed: [signature] date 9-25-00 Installed by:

Improvement Permit by: [signature] date 11/7/00 Operation Permit by: date

Authorization to Construct by: date Existing System Inspection by: date

HEALTH DEPT. COPY: WHITE OWNER COPY (FINAL): YELLOW OWNER COPY (INITIAL): PINK