IREDELL COUNTY HEALTH DEPARTMENT

STATESVILLE 704-878-5305 MOORESVILLE 704-664-5281

IMPROVEMENT PERMIT / AUTHORIZATION TO CONSTRUCT / OPERATION PERMIT / EXISTING SYSTEM INSPECTION

PERMIT# 92437 PIN# ~~4626-35-7480-PT~~ 4626-29-6418 DATE 11/7/00

OWNER OR CONTRACTOR EASTER DEV. // Lewis Carpenter PHONE: Business 664-2906 Home

ADDRESS 227 HIDEAWAY LN MOORESVILLE

LOCATION BRAWLEY SCHOOL - TR MCKENDREE - TR LAKEVIEW - ON RT

SUBDIVISION BLACKBERRY CREEK BLOCK / SECTION 2 LOT 2 LOT AREA .714c SITE CLASS. FS DESIGN FLOW 360.00 L.T.A.R. .3gpd/ft2

Septic Tank: 1000 Gallons; STB 794 Date 10/25/01

Pump Tank: Gallons; PT Date

Pump Make: Model Serial No.

Nitrification Field: No Fields 1 Square Feet 900 Linear Feet 300

No Lines 4@75' Trench Width 36" Max Trench Bottom Depth 36" Gravel Depth #57

☒ New System ☐ Repair System Type: I, II, III, IV, V, VI

System Description: GRAVITY 25% REDUCTION

Repair System Description: PANEL/SAME

Maintenance Agreement Required: ☐ Yes ☒ No

☒ House/Mod. Home No. Bedrooms 3

☐ Mobile Home No. Bathrooms 3

☐ Business No. Employees

☐ Other

☐ Slab ☑ Crawl Space ☐ Basement w/plumbing ☐ Basement wo/plumbing


Water Supply: ☒ Individual ☐ Public ☐ Community

Comments:/Conditions: 1) REMOVE TERRACES AND BERMS


Dec 7 01 Reviewed house plan; in compliance w/ IP. To be located as shown on sketch DRT

Comments:/Conditions: Infiltrator shy tailed. No well on site. 5/20/02

INITIAL SITE SKETCH 1"=50'

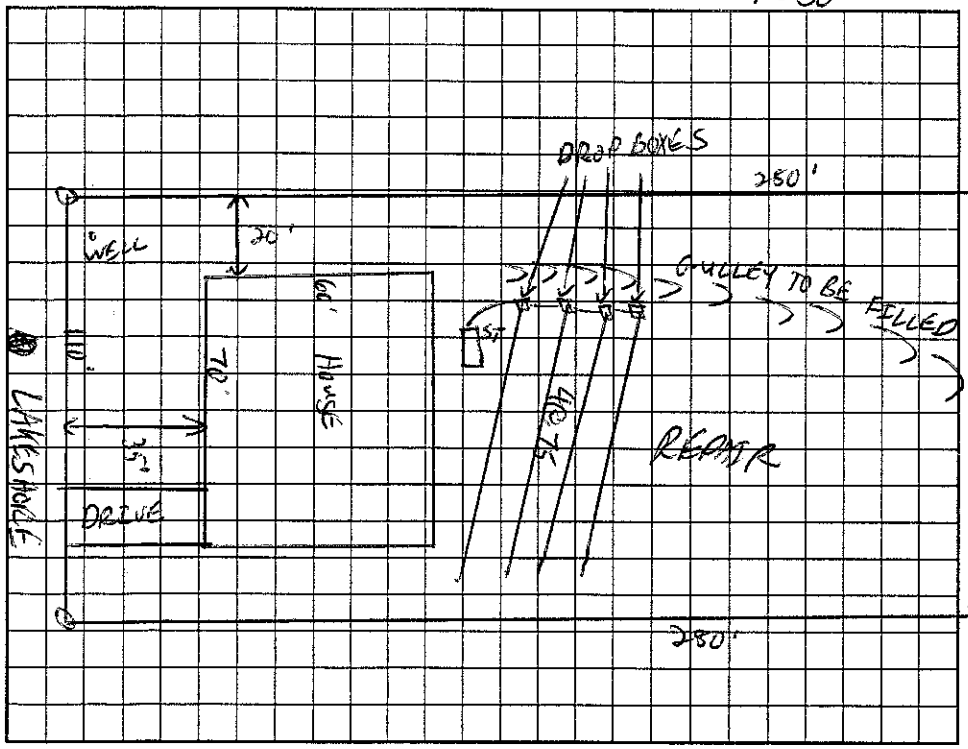

AS BUILT SKETCH

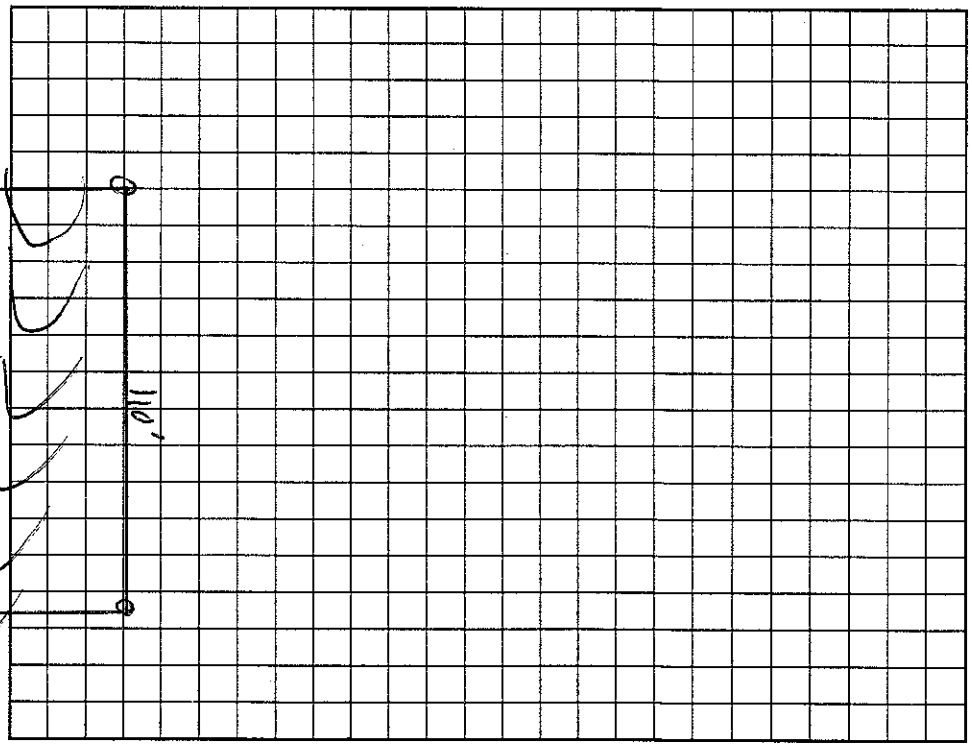

Permit can be suspended or revoked if any false information is supplied toward securing the permit/any unauthorized changes are made to the site/any unauthorized changes are made in the installation of the system. Improvement Permit with plat valid without expiration. Improvement Permit with site plan valid for sixty months. Authorization to Construct is valid for a period equal to that of Improvement Permit – not to exceed sixty months.

Signed: date 11-9-00

Improvement Permit by: date 11/7/00

Authorization to Construct by: date 12-7-01

Installed by: Larry Beam

Operation Permit by: Wesley Sparks RS. date 5/20/02

Existing System Inspection by: date

HEALTH DEPT. COPY: WHITE OWNER COPY (FINAL): YELLOW OWNER COPY (INITIAL): PINK