(9:30) Tommy Frye

IREDELL COUNTY HEALTH DEPARTMENT

STATESVILLE 704-878-5305 MOORESVILLE 704-664-5281

IMPROVEMENT PERMIT / CERTIFICATE OF COMPLETION / OPERATION PERMIT / EXISTING SYSTEM INSPECTION

PROPERTY DESCRIPTION NO. 21633 DATE July 17, '95 TAX MAP NO. 2L34354 4626 29 6704 Watershed: ☑ Yes ☐ No

OWNER OR CONTRACTOR Michael VanGieu PHONE: Business _____ Home _____ WS4

ADDRESS 3315 Clarkson St Charlotte

LOCATION Brawley Sch Rd, TR McKendree TR 1st Lakeview Dr on Right across from Abbott Lane

SUBDIVISION Crescent BLOCK / SECTION _____ LOT 1609 LOT AREA ~1/2 Acre SITE CLASS. B5 DESIGN FLOW 360gpd L.T.A.R. .3

Septic Tank: 1000 Gallons; STB 1013 Date 7-7-96

Pump Tank: 1000 Gallons; PT _____ Date _____

Pump Make: _____ Model _____ Serial No. _____

Nitrification Field: No. Fields 1 Square Feet 1600 + Linear Feet 534+

No. Lines 5 Trench Width 36" Max Trench Bottom Depth 24" Gravel Depth 12"

☑ New System ☐ Repair System Type: I, II, (III), IV, V, VI

System Description: Pump Conventional

Repair System Description: Same

Maintenance Agreement Required: ☐ Yes ☑ No

☑ House/Mod. Home ☐ Mobile Home ☐ Business ☐ Other

No. Bedrooms 4 No. Bathrooms 4 No. Employees ____

☐ Slab ☐ Crawl Space ☑ Basement w/plumbing ☐ Basement wo/plumbing

Water Supply: ☑ Individual ☐ Community ☐ Public

Comments: Changed to 3BR home, 3 cent of Ch Plastic behind house - eliminate PT and pump - Ans


5 taps - 1½" 6"oc

Comments: JRH 8-21-95

INITIAL SITE SKETCH



AS BUILT SKETCH

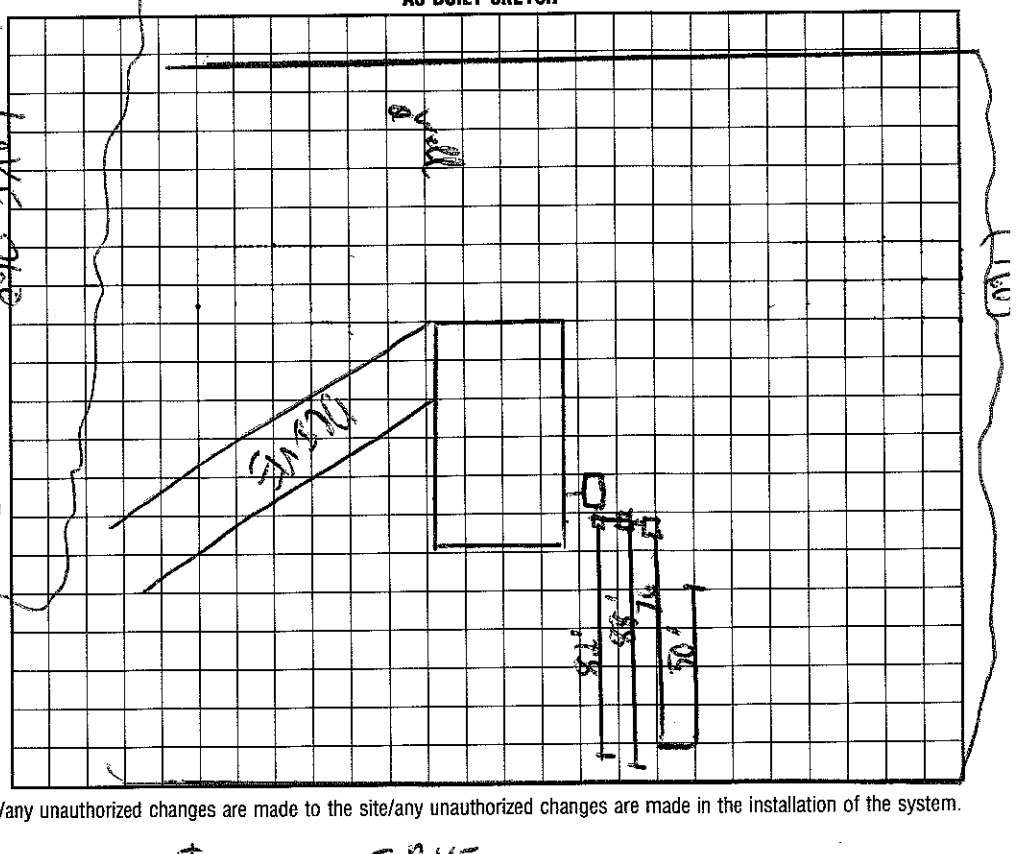

I understand that this permit can be suspended or revoked if any false information is supplied toward securing the permit/any unauthorized changes are made to the site/any unauthorized changes are made in the installation of the system. Improvement Permit is valid for 60 months from date of issuance.

Signed: _____

Improvement Permit by: Steve Hinson, RS date 7-17-95

Final Inspection by: _____ date _____

Installed by: Tommy Frye

Certificate of Completion by: _____ date _____

Operation Permit by: C. Frye EHS date 10/16/96

HEALTH DEPT. COPY: WHITE INSPECTION COPY (FINAL): GREEN OWNER COPY (FINAL): YELLOW INSPECTION COPY (INITIAL): PINK OWNER COPY (INITIAL): GOLD