IREDELL COUNTY HEALTH DEPARTMENT

Statesville Office (704) 878-5305 Mooresville Office (704) 660-3625 PERMIT # 215396

IMPROVEMENT PERMIT / AUTHORIZATION TO CONSTRUCT / OPERATION PERMIT / EXISTING SYSTEM

PIN # 4626296704

APPLICANT: Anthony Sylvan Pools/Mike Whyte APPLICANT ADDRESS: 8334-A Arrowridge Blvd Charlotte, NC 28273

SITE ADDRESS: 136 Lakeview Shores Dr Mooresville, NC PHONE: ALT. PHONE:

SITE DIRECTIONS: Brawley School Rd TR McKendree TR 1st Lakeview Dr on right across From Abbot Ln


SUBDIVISION: CLOT SECTION: 8 LOT # 11609 LOT AREA: 1.66 Acres DESIGN FLOW: 360gpd L.T.A.R.: .3

Existing


Septic Tank	1000	(gal)	STB		Date		☐ New System	☐ Repair	☐ Expansion	System Type: I II III IV V VI		☒ Residence	No. Bedrooms	3	Water Supply	
Pump Tank		(gal)	PT		Date		System Description: Existing Gravity-Chamber Plastic					☐ Business	No. Persons	6	☒ Private	
Pump Make		Model			Serial #		Repair System Description: Pump Conventional					☐ Other	No. Employees		☐ Public	
# Nitrification Fields	1	# Lines	4		Linear Ft:	300'	Maintenance Agreement Required:	☐ YES	☒ NO			☐ Slab	☐ Crawl Space		☐ Community	
Existing Trench Width	36"	Max. Trench Bottom Depth	24		Gravel Depth	N/A		☒ GRAVITY	☐ PRESSURE			☒ Basement w/plumbing			☐ Basement w/o plumbing	

Comments / Conditions: * Must keep inground pool at least 15ft from Septic tank (ST) and Drainfield.

INITIAL SITE SKETCH

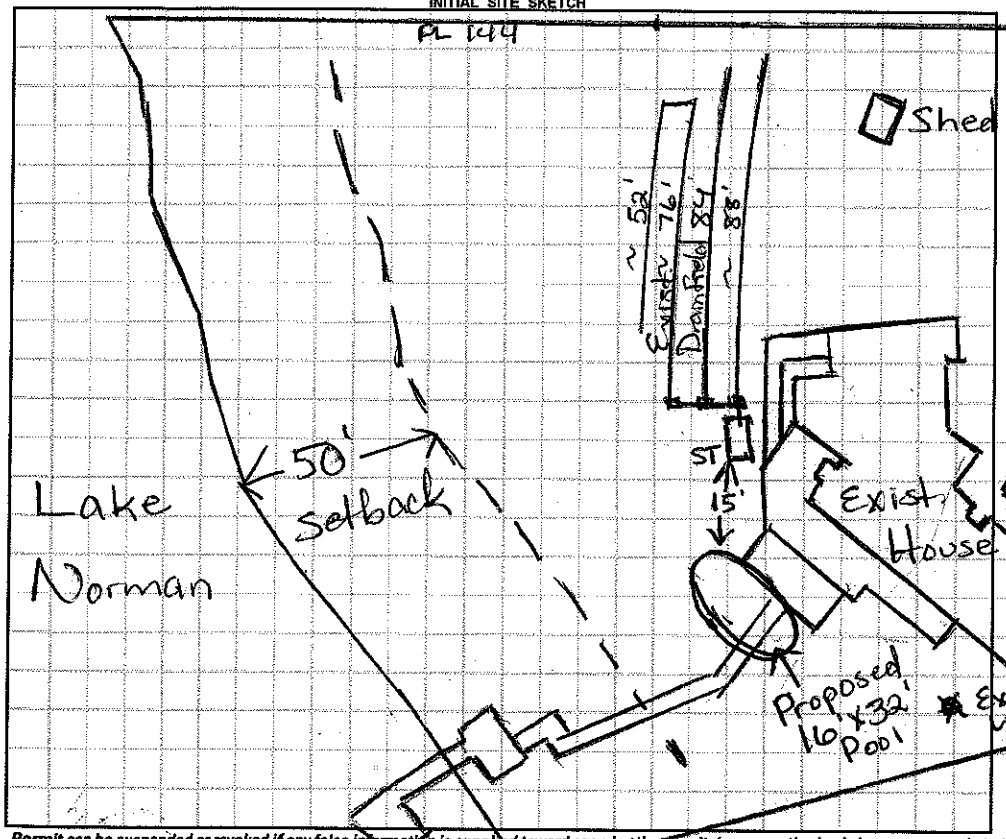

AS BUILT SKETCH

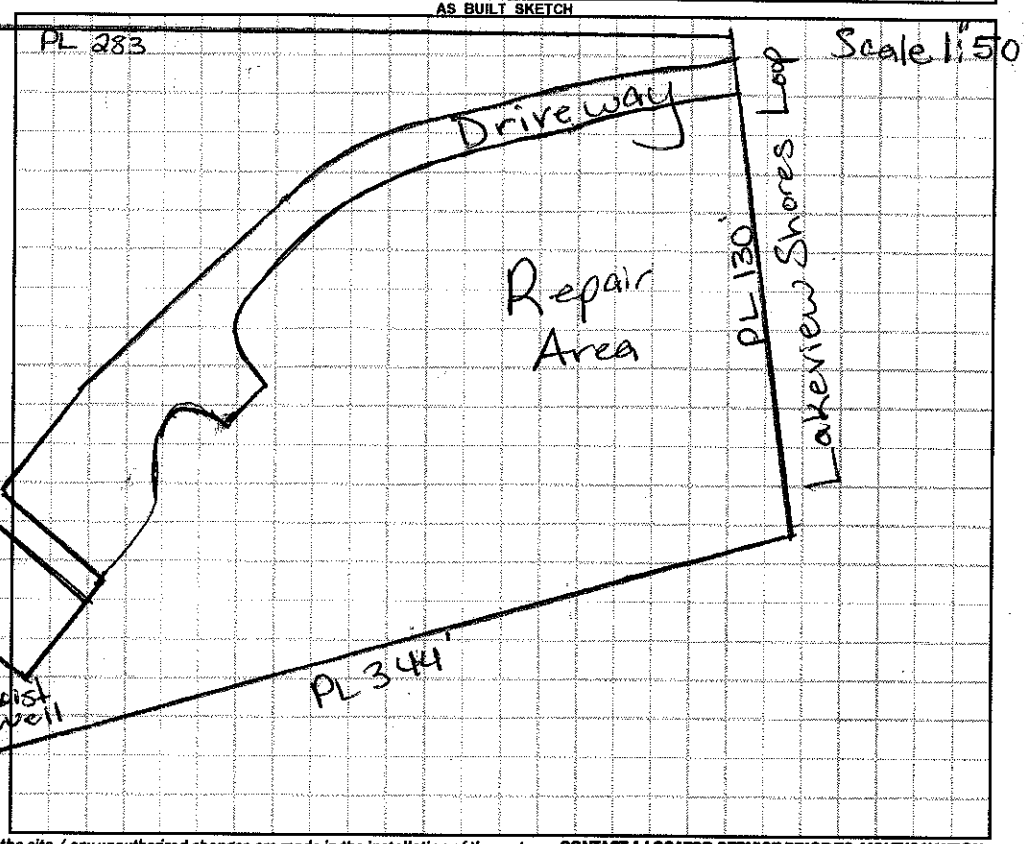

Permit can be suspended or revoked if any false information is supplied toward securing the permit / any unauthorized changes are made to the site / any unauthorized changes are made in the installation of the system. **CONTACT A LOCATOR SERVICE PRIOR TO ANY EXCAVATION**

☐ **IMPROVEMENT PERMIT** *with plat valid without expiration.* ☐ **IMPROVEMENT PERMIT** *with site plan valid for 60 mos.* ☐ **AUTHORIZATION TO CONSTRUCT** *valid for period equal to IMPROVEMENT PERMIT--not to exceed 60 mo.*

Owner / Applicant Signature: MTB Date: 2-2-16 Installed by:

IMPROVEMENT PERMIT by: Date: OPERATION PERMIT by: Date:

AUTHORIZATION TO CONSTRUCT by: Date: Existing System Inspected by: Maria Hill Dotson RS Date: 1/25/16

Health Dept. Copy - WHITE Applicant (Final Approval) - YELLOW Applicant (Conditional Approval) - PINK