IREDELL COUNTY HEALTH DEPARTMENT

Statesville Office (704) 878-5305 Mooresville Office (704) 660-3625 PERMIT # 207092

IMPROVEMENT PERMIT / AUTHORIZATION TO CONSTRUCT / OPERATION PERMIT / EXISTING SYSTEM

PIN # 4626-29-8255

APPLICANT: JASPER BUILDERS APPLICANT ADDRESS: 181 W. STATESVILLE AVE. MVILLE

SITE ADDRESS: 494 MCKENDREE RD PHONE: 704-799-9982 ALT. PHONE:

SITE DIRECTIONS: BSR, TR MCKENDREE, ON R

SUBDIVISION: BLACKBERRY CREEK SECTION: 2 LOT # 6 LOT AREA: .701 AC DESIGN FLOW: 360 L.T.A.R.: .3

Septic Tank 1000 (gal) STB 794 Date 5-8-15

Pump Tank (gal) PT Date

Pump Make Model Serial #

Nitrification Fields 1 # Lines 3 Linear Ft: 302'

Trench Width 36" Max. Trench Bottom Depth 36" Gravel Depth —

☒ New System ☐ Repair ☐ Expansion System Type: I II ⓘ IV V VI

System Description: 25% REDUCTION

Repair System Description: DRIP

Maintenance Agreement Required: ☐ YES ☒ NO

☒ GRAVITY ☐ PRESSURE

☒ Residence No. Bedrooms 3

☐ Business No. Persons

☐ Other No. Employees

☐ Slab ☒ Crawl Space

☐ Basement w/plumbing ☐ Basement w/o plumbing

Water Supply: ☐ Private ☐ Public ☒ Community

Comments / Conditions: ENSURE SYSTEM IS IN NATURAL SOIL ON INSTALL

INITIAL SITE SKETCH

SEE PLAN BY MICHAEL ATHANAS & ASSOCIATES

AS BUILT SKETCH

CHECKED TANKS & 1ST 2 LINES

APPROVED JUN 10 2015 BA

Permit can be suspended or revoked if any false information is supplied toward securing the permit / any unauthorized changes are made to the site / any unauthorized changes are made in the installation of the system. **CONTACT A LOCATOR SERVICE PRIOR TO ANY EXCAVATION**


☐ **IMPROVEMENT PERMIT** *with plat valid without expiration.* ☐ **IMPROVEMENT PERMIT** *with site plan valid for 60 mos.* ☒ **AUTHORIZATION TO CONSTRUCT** *valid for period equal to IMPROVEMENT PERMIT--not to exceed 60 mo.*

Owner / Applicant Signature: Date: 5/27/15 Installed by: ABERNATHY

IMPROVEMENT PERMIT by: APPROVED Date: MAY 27 2015 OPERATION PERMIT by: APPROVED Date: JUN 11 2015

AUTHORIZATION TO CONSTRUCT by: APPROVED Date: MAY 27 2015 Existing System Inspected by: Date:

Health Dept. Copy - WHITE Applicant (Final Approval) - YELLOW Applicant (Conditional Approval) - PINK

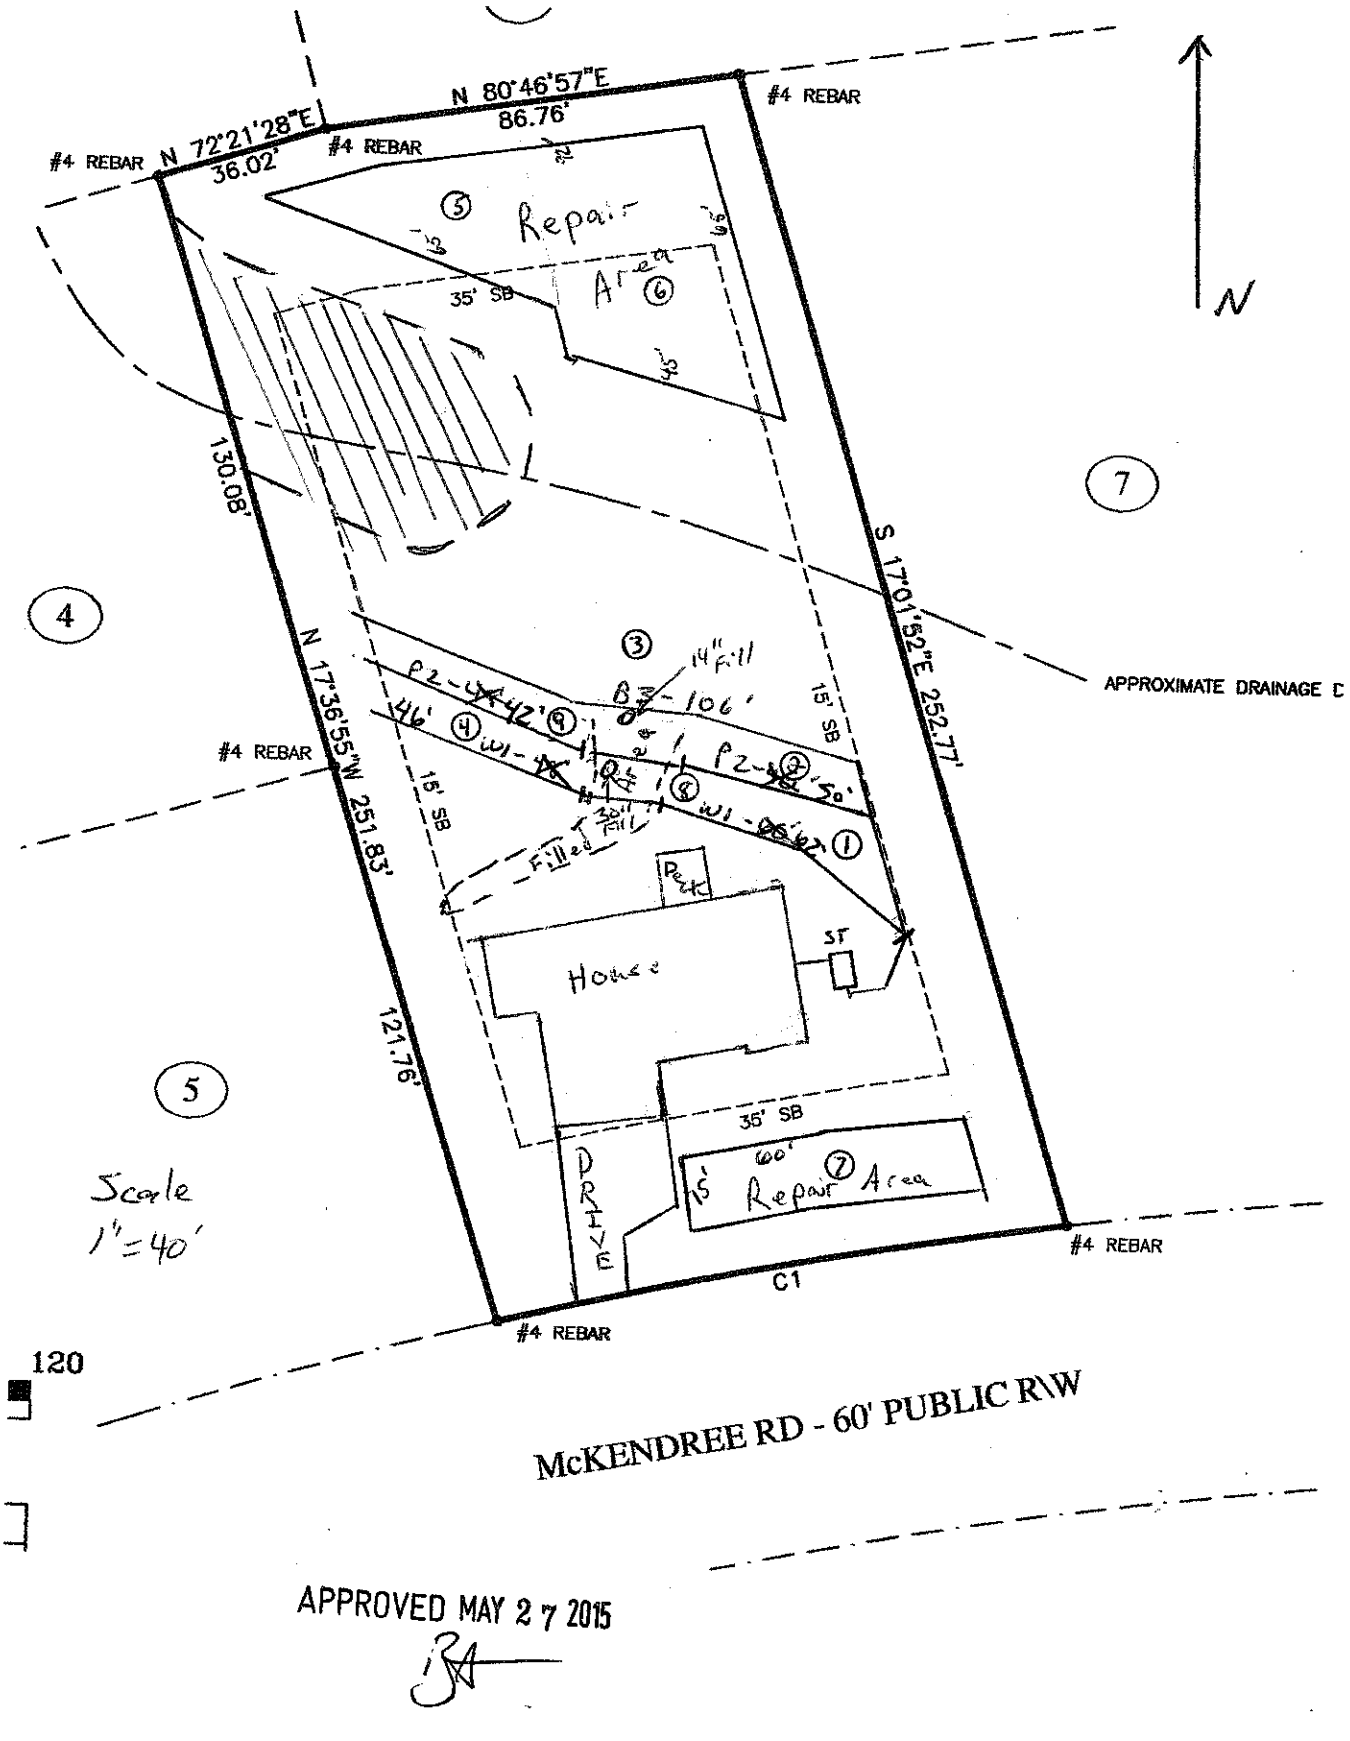

APPROVED MAY 2 7 2015