IREDELL COUNTY HEALTH DEPARTMENT

Statesville Office (704) 878-5305 Mooresville Office (704) 660-3625 PERMIT # 215278

IMPROVEMENT PERMIT / AUTHORIZATION TO CONSTRUCT / OPERATION PERMIT / EXISTING SYSTEM

PIN # 4626298428

APPLICANT: David Bellafaire APPLICANT ADDRESS: 484 McKendree Rd Mooresville, NC 28117

SITE ADDRESS: 484 McKendree Mooresville, NC PHONE: ALT. PHONE: Kathleen 704 578-4951

SITE DIRECTIONS: Brawley School Rd TR McKendree on right after Aramore

SUBDIVISION: Blackberry Creek II SECTION: 2 LOT # 17 LOT AREA: 1.55 Ac DESIGN FLOW: 600gpd L.T.A.R.: .3

Septic Tank 1500 (gal) STB 190 Date 10-9-15
Pump Tank (gal) PT Date
Pump Make Model Serial #
Nitrification Fields 1 # Lines 3 (Add to Exist) Linear Ft: 200'
Trench Width 36" Max. Trench Bottom Depth 36" Gravel Depth N/A

☒ New System ☐ Repair ☐ Expansion System Type: I II III IV V VI
System Description: Gravity - 25% Reduction
Repair System Description: LPPBPS
Maintenance Agreement Required: ☐ YES ☒ NO
☒ GRAVITY ☐ PRESSURE

☒ Residence No. Bedrooms 5
☐ Business No. Persons 10
☐ Other No. Employees
☐ Slab ☒ Crawl Space
☐ Basement w/plumbing ☐ Basement w/o plumbing

Water Supply: ☒ Private ☐ Public ☐ Community

Comments / Conditions: Add 200ft to existing Drainfield for total of 500ft. to Upgrade to 5 Bedrooms.

INITIAL SITE SKETCH

See attached/approved plan by Kathleen Saunders for Upgrade dated 11/28/15

AS BUILT SKETCH

Permit can be suspended or revoked if any false information is supplied toward securing the permit / any unauthorized changes are made to the site / any unauthorized changes are made in the installation of the system. **CONTACT A LOCATOR SERVICE PRIOR TO ANY EXCAVATION**


☐ **IMPROVEMENT PERMIT** *with plat valid without expiration.* ☐ **IMPROVEMENT PERMIT** *with site plan valid for 60 mos.* ☒ **AUTHORIZATION TO CONSTRUCT** *valid for period equal to IMPROVEMENT PERMIT--not to exceed 60 mo.*

Owner / Applicant Signature: Kathleen Saunders Date: 12/18/15 Installed by: BARNES BACKHOE

IMPROVEMENT PERMIT by: Maria Hall Dotson RS Date: 12/17/15 OPERATION PERMIT by: RA-08 Date: 1-14-16

AUTHORIZATION TO CONSTRUCT by: Maria Hall Dotson RS Date: 12/17/15 Existing System Inspected by: Date:

Health Dept. Copy - WHITE Applicant (Final Approval) - YELLOW Applicant (Conditional Approval) - PINK

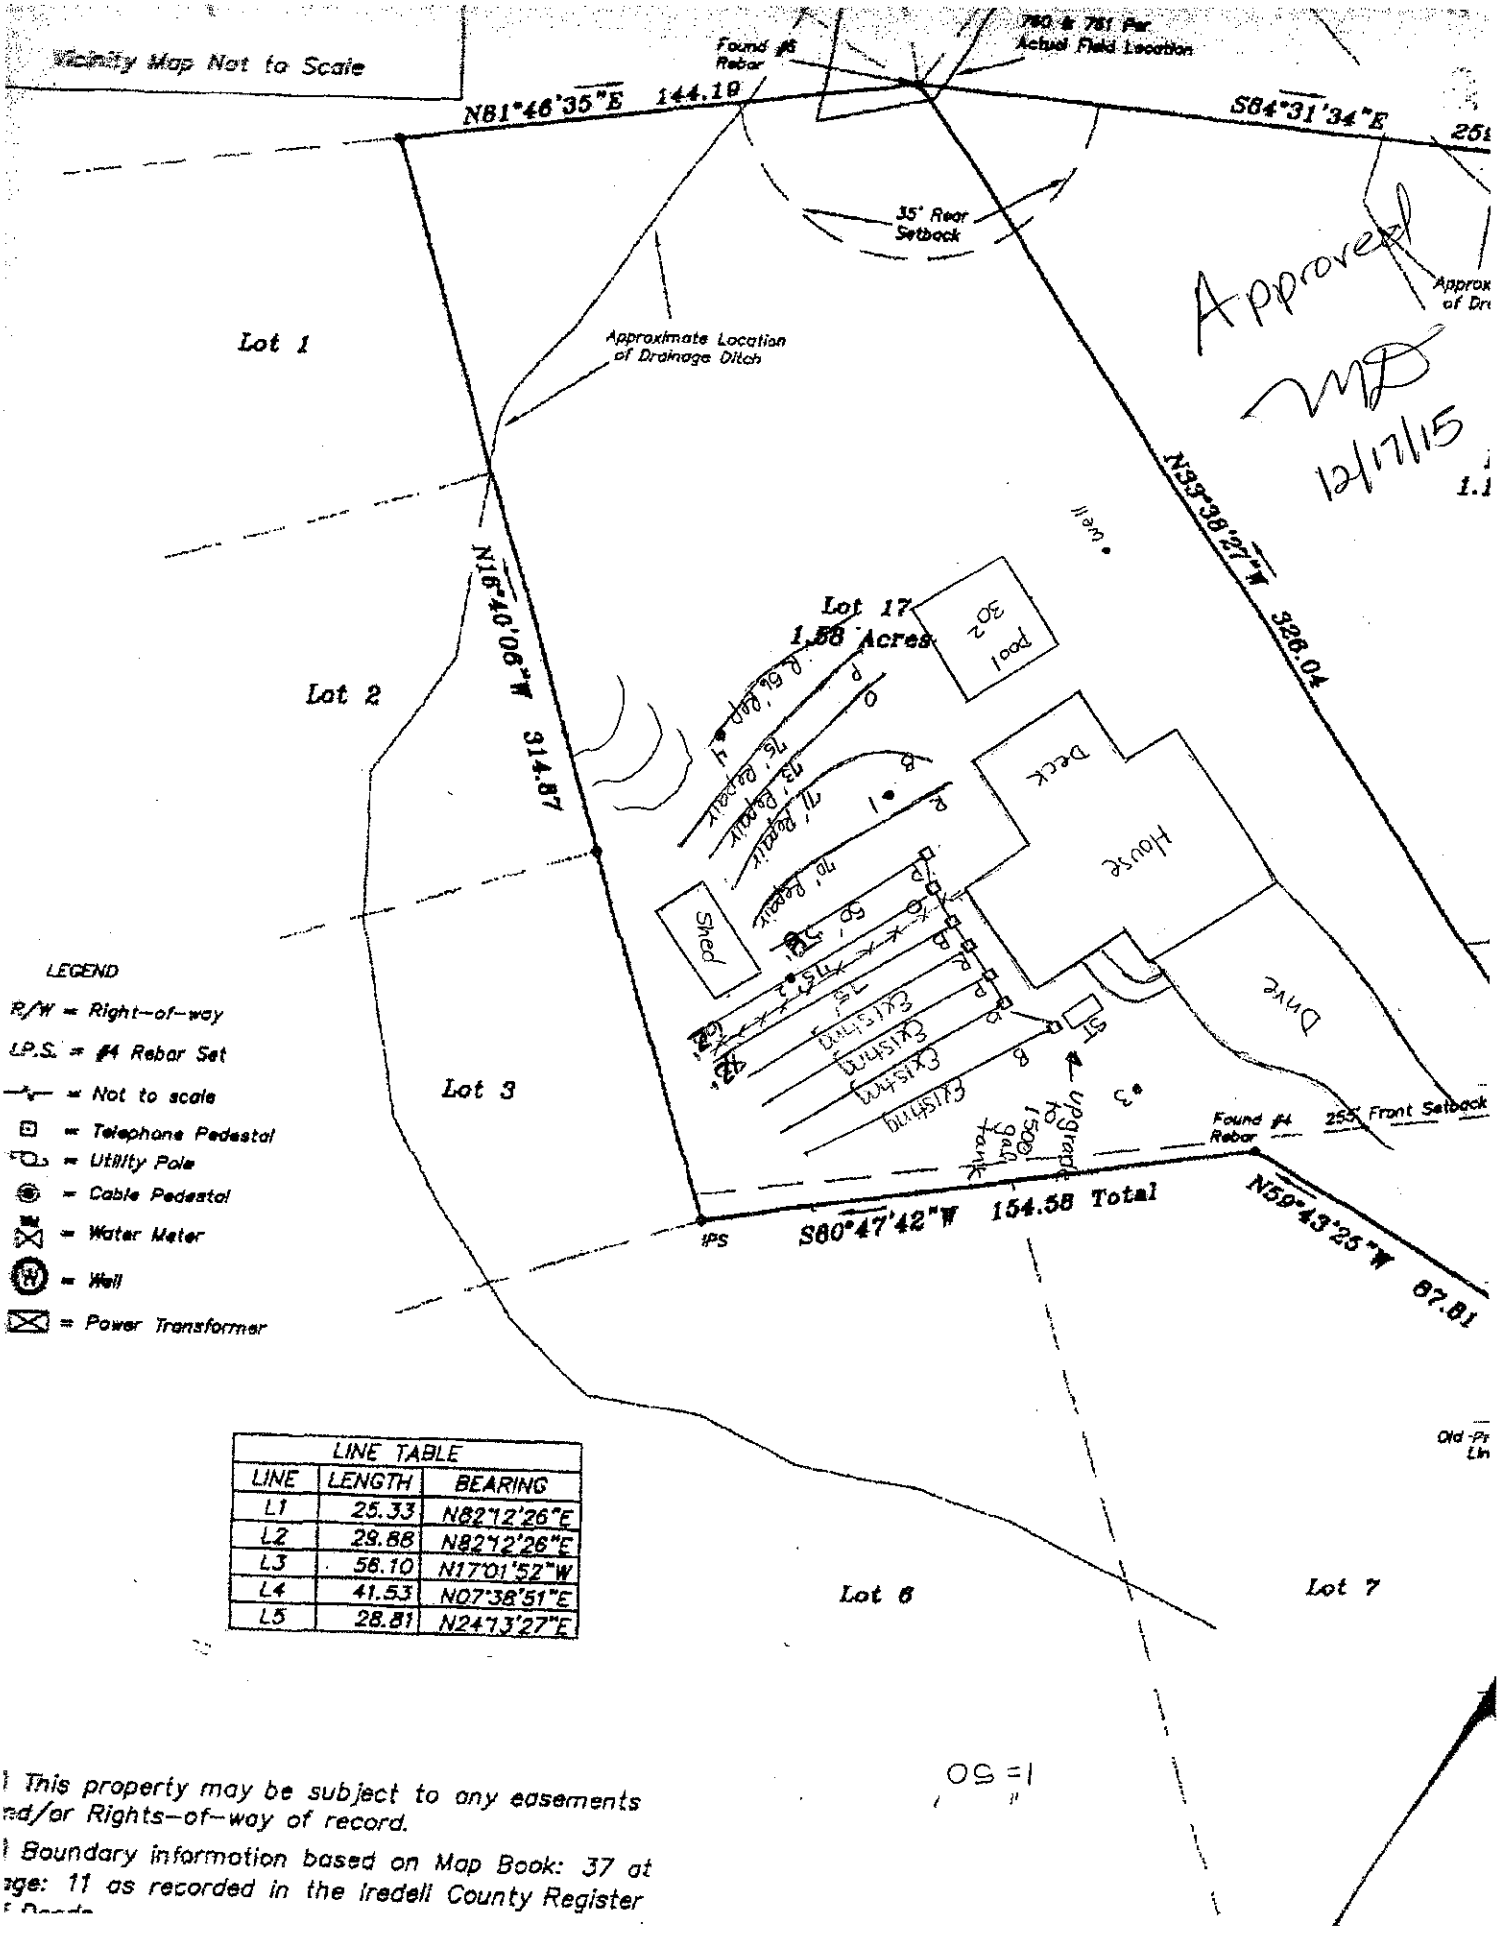

LINE TABLE		
LINE	LENGTH	BEARING
L1	25.33	N82°12'26"E
L2	29.88	N82°12'26"E
L3	56.10	N17°01'52"W
L4	41.53	N07°38'51"E
L5	28.81	N24°13'27"E

This property may be subject to any easements and/or Rights-of-way of record.

Boundary information based on Map Book: 37 at Page: 11 as recorded in the Iredell County Register of Deeds.