IREDELL COUNTY HEALTH DEPARTMENT

STATESVILLE 704-878-5305 MOORESVILLE 704-664-5281

IMPROVEMENT PERMIT / AUTHORIZATION TO CONSTRUCT / OPERATION PERMIT / EXISTING SYSTEM INSPECTION

PERMIT# 92478 PIN# 4626-29-8428 DATE 11/9/00

OWNER OR CONTRACTOR EASTER DEV. CORP. / LEWIS CARPENTER PHONE: Business 664-2906 Home

ADDRESS 227 HIDEAWAY LN MOORESVILLE NC 28117

LOCATION BRAWLEY SCHOOL - TR MCKENDREE - ON RT

SUBDIVISION BLACKBERRY CREEK BLOCK / SECTION II LOT 17 LOT AREA 1.55AC SITE CLASS. PS DESIGN FLOW 360GPD L.T.A.R. 30-00/1992

Septic Tank: 1000 Gallons; STB 794 Date 8/27/01

Pump Tank: Gallons; PT Date

Pump Make: Model Serial No.

Nitrification Field: 1 Square Feet 900 Linear Feet 300

No Lines 5@60' Trench Width 36" Max Trench Bottom Depth 36" Gravel Depth N/A

☑ New System ☐ Repair System Type: I, II, III, IV, V, VI

System Description: CLARITY 25% REDUCTION

Repair System Description: SAME

Maintenance Agreement Required: ☐ Yes ☑ No

☑ House/Mod. Home No. Bedrooms 3

☐ Mobile Home No. Bathrooms 2.5

☐ Business No. Employees

☐ Other


☐ Slab ☑ Crawl Space ☐ Basement w/plumbing ☐ Basement wo/plumbing

Water Supply: ☑ Individual ☐ Public ☐ Community


Comments:/Conditions: REMOVE TERRACES AND BERMS

Comments:/Conditions:

INITIAL SITE SKETCH

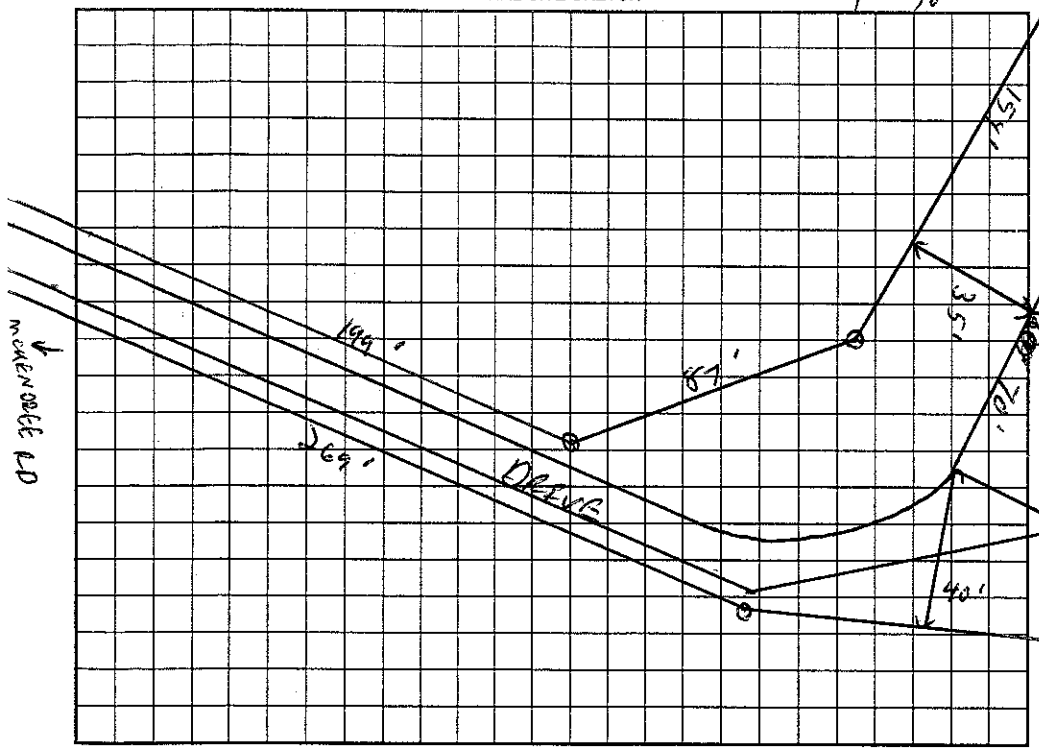

AS BUILT SKETCH

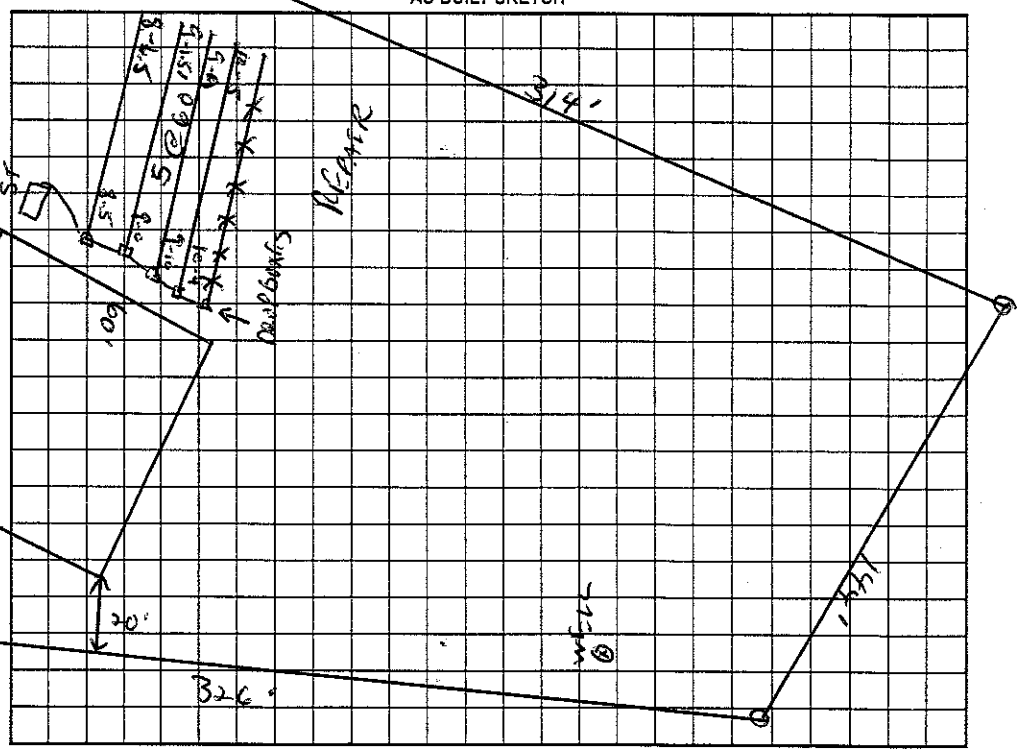

Permit can be suspended or revoked if any false information is supplied toward securing the permit/any unauthorized changes are made to the site/any unauthorized changes are made in the installation of the system. Improvement Permit with plat valid without expiration. Improvement Permit with site plan valid for sixty months. Authorization to Construct is valid for a period equal to that of Improvement Permit – not to exceed sixty months.

Signed: date 11-9-00 Installed by: Larry Beaver

Improvement Permit by: RS date 11/9/00 Operation Permit by: Wesley Sparks RS date 10/29/01

Authorization to Construct by: RS date 6/29/01 Existing System Inspection by: date

HEALTH DEPT. COPY: WHITE OWNER COPY (FINAL): YELLOW OWNER COPY (INITIAL): PINK