Called in 12/22/03 1:30

IREDELL COUNTY HEALTH DEPARTMENT

STATESVILLE 704-878-5305 MOORESVILLE 704-664-528

IMPROVEMENT PERMIT / AUTHORIZATION TO CONSTRUCT / OPERATION PERMIT / EXISTING SYSTEM INSPECTION

PERMIT# 065681 PIN# 4625 94 1684 (pt.) 4626-30-0084 DATE 12/14/00

OWNER OR CONTRACTOR ~~Jim Bechtold~~ TIM TINKHAM PHONE: Business 660-0891 Home

ADDRESS 141 Hunters Pointe Ln. Mooresville, NC. 28117

LOCATION 11.00 TR Bay Harbour TR Shipyard Pt. TR Cedar Cove Ln. corner lot on (L) 128 Shipyard Pt Rd.

SUBDIVISION Harbour BLOCK / SECTION 6 LOT 13 LOT AREA .16 Ac SITE CLASS. RS DESIGN FLOW 480 L.T.A.R. .3

Septic Tank: 1000 Gallons; STB 312 Date 3/21/03
Pump Tank: 1000 Gallons; PT 283 Date 8/24/03
Pump Make: Model Serial No.
Nitrification Field: No Fields 1 Square Feet 1200± Linear Feet 400±
No Lines 4@100' Trench Width 3' Max Trench Bottom Depth 3' Gravel Depth SAND.

[X] New System [ ] Repair System Type: I, II, [III], IV, V, VI
System Description: Pres Mon. - EZ Flow Ch. Plastic
Repair System Description: Same type
Maintenance Agreement Required: [ ] Yes [X] No


[X] House/Mod. Home No. Bedrooms 4
[ ] Mobile Home No. Bathrooms 4
[ ] Business No. Employees
[ ] Other
[ ] Slab [ ] Crawl Space [X] Basement w/plumbing [ ] Basement wo/plumbing

Water Supply: [ ] Individual [ ] Public [X] Community

Comments:/Conditions:

(1" = 50')

INITIAL SITE SKETCH

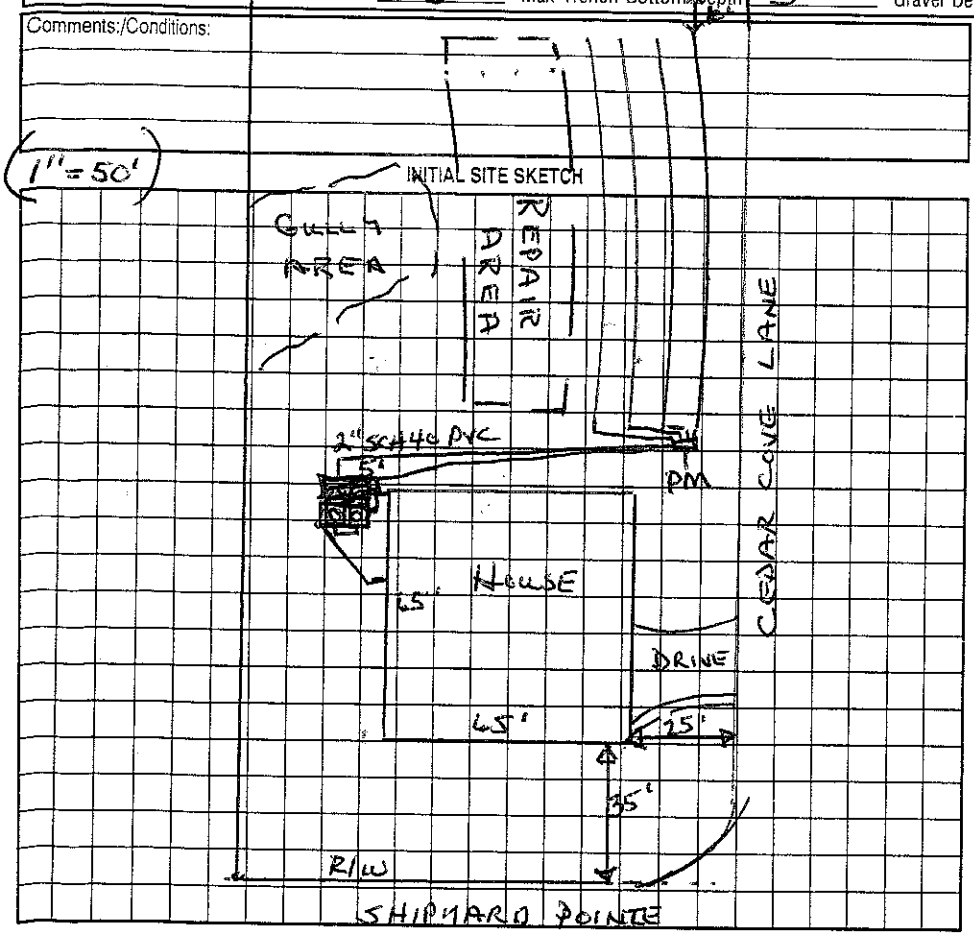

Comments:/Conditions:

AS BUILT SKETCH

Permit can be suspended or revoked if any false information is supplied toward securing the permit/any unauthorized changes are made to the site/any unauthorized changes are made in the installation of the system. Improvement Permit with plat valid without expiration. Improvement Permit with site plan valid for sixty months. Authorization to Construct is valid for a period equal to that of Improvement Permit – not to exceed sixty months.

Signed: ± date

Improvement Permit by: Wesley Sparks RS. date 12/14/00

Authorization to Construct by: Wesley Sparks RS. date 12/14/00

Installed by: Richard Abernathy

Operation Permit by: Wesley Sparks RS. date 12/21/03

Existing System Inspection by: date

HEALTH DEPT. COPY: WHITE OWNER COPY (FINAL): YELLOW OWNER COPY (INITIAL): PINK