(11:30)

IREDELL COUNTY HEALTH DEPARTMENT

STATESVILLE 704-878-5305 MOORESVILLE 704-664-5281

IMPROVEMENT PERMIT / CERTIFICATE OF COMPLETION / OPERATION PERMIT / EXISTING SYSTEM INSPEC

PROPERTY DESCRIPTION NO. 065671 DATE 11/13/97 TAX MAP NO. ~~4625941654~~ Watershed: ☐

OWNER OR CONTRACTOR JOHN WHITLEY ~~PHONE-Business~~ 4626-30-1523 Home 536-4728

ADDRESS 9009 ALBEMARLE RD SUITE 101-206

LOCATION BRAWLEY SCH - TR BAY HARBOUR - TR SHIPYARD - TR ~~CODE~~ CADE'S COVE - AT END

SUBDIVISION HARBOUR BLOCK / SECTION 6 LOT 10 LOT AREA — SITE CLASS. A DESIGN FLOW 480 GPD L.T.A.R. .3000/FT²

Septic Tank: 1000 Gallons; STB 794 Date 6/16/48

Pump Tank: ____ Gallons; PT ____ Date ____

Pump Make: ____ Model ____ Serial No. ____

Nitrification Field: No Fields 1 Square Feet 1200 Linear Feet 406

No Lines 5 @ 80' Trench Width 36" Max Trench Bottom Depth 36" Gravel Depth N/A

☑ New System ☐ Repair System Type: I, II, III, IV, V, VI

System Description: GRAVITY CHAMBERED OR HDS

Repair System Description: PUMP PANEL

Maintenance Agreement Required: ☐ Yes ☑ No

☑ House/Mod. Home No. Bedrooms 4

☐ Mobile Home No. Bathrooms 4½

☐ Business No. Employees ____

☐ Other ____


☐ Slab ☑ Crawl Space ☑ Basement w/plumbing ☐ Basement wo/plumbing

Water Supply: ☐ Individual ☑ Community ☐ Public


Comments: REVISED

Comments: LINES SLIGHTLY DEEPER ON END B/C NOT RUN ON CONTOUR.

INITIAL SITE SKETCH 1" = 50'

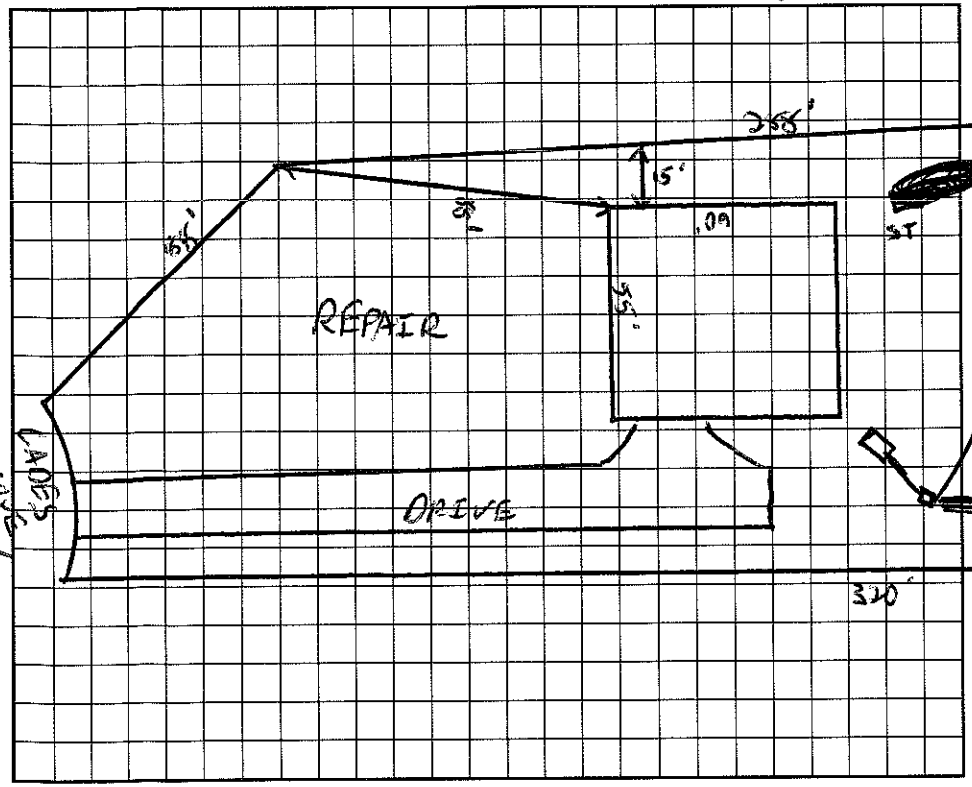

AS BUILT SKETCH

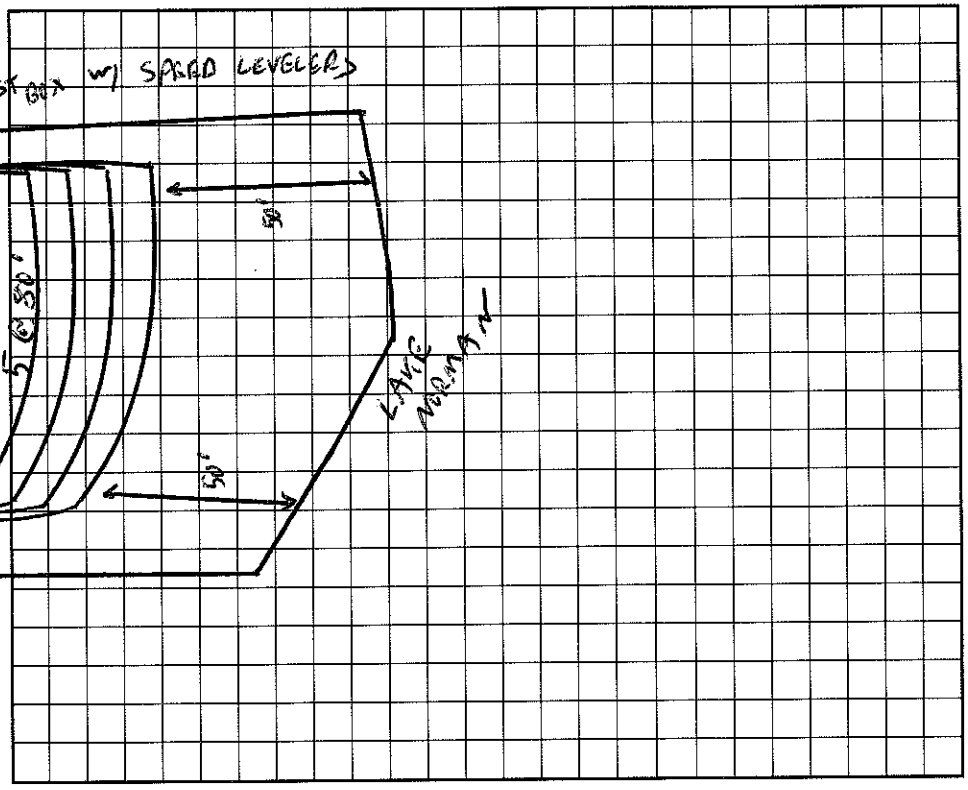

I understand that this permit can be suspended or revoked if any false information is supplied toward securing the permit/any unauthorized changes are made to the site/any unauthorized changes are made in the installation of the system. Improvement Permit is valid for 60 months from date of issuance.

Signed: Jennifer Whitley

Improvement Permit by: [signature] date 11/13/97

Existing System Inspection by: [signature] date 11/13/97

Installed by: A CORNERS GRADING

Certificate of Completion by: ____ date ____

Operation Permit by: [signature] date 7/30/98

HEALTH DEPT. COPY: WHITE INSPECTION COPY (FINAL): GREEN OWNER COPY (FINAL): YELLOW INSPECTION COPY (INITIAL): PINK OWNER COPY (INITIAL): GOLD