IREDELL COUNTY HEALTH DEPARTMENT

STATESVILLE 704-878-5305 MOORESVILLE 704-664-5281

250.00 Paid 3:00

IMPROVEMENT PERMIT / AUTHORIZATION TO CONSTRUCT / OPERATION PERMIT / EXISTING SYSTEM INSPECTION

PERMIT# 065670 PIN# 4625944684 (pt) 4626-30-2570 DATE 4/16/2001

OWNER OR CONTRACTOR David Jackie Scott (Lloyd Hartman) PHONE Business Home

ADDRESS 2320 Sharon Rd Charlotte NC 28207

LOCATION Brawley School Rd TR Bay Harbour TR Shipyard Pt TR Cadels Cove Ln at end

SUBDIVISION Harbour BLOCK / SECTION 6 LOT 19 LOT AREA 43,780 sq ft SITE CLASS. PS DESIGN FLOW 480 gpd L.T.A.R. .3 - .35

Septic Tank: 1000 Gallons; STB 794 Date 9-9-0

Pump Tank: 1000 Gallons; PT 27 Date 9-2-0

Pump Make: Goulds Model WE07121T Serial No. 8030947902

Nitrification Field: No Fields 1 Square Feet 840' Linear Feet 280'

No Lines 5 Trench Width 24" Max Trench Bottom Depth 30" Gravel Depth N/A

[X] New System [ ] Repair System Type: I, II, III, IV, V, VI (Type 4)

System Description: Pump (LP) Pavei Block

Repair System Description: Same

Maintenance Agreement Required: [X] Yes [ ] No

[X] House/Mod. Home No. Bedrooms 4

[ ] Mobile Home No. Bathrooms 4

[ ] Business No. Employees

[ ] Other


[ ] Slab [ ] Crawl Space [X] Basement w/plumbing [ ] Basement wo/plumbing

Water Supply: [ ] Individual [ ] Public [X] Community

Comments/Conditions: Must keep Septic System 25' Upgradient of Basement wall, only 5' from Garage foundation. Keep Septic System at least 50' from Lake & Creek.

Comments/Conditions: * Hug Property Line with driveway. Keep Drainlines 15' from any cut 72' unless "properly" filled. Do Not Cut, Fill or Grade over designated Septic areas.


Scale 1:50 INITIAL SITE SKETCH

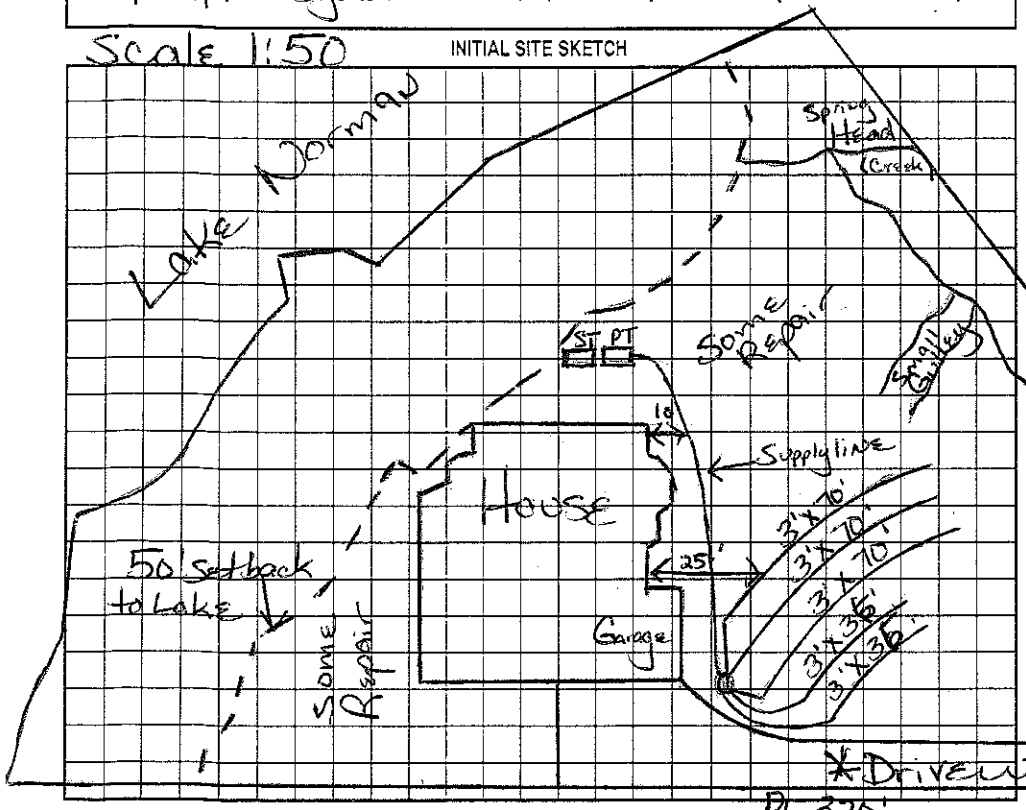

AS BUILT SKETCH

Keep Supply line away from Basement at - 10'. @ lines 1-4 10/12/01 Checked tanks

* Filter installed

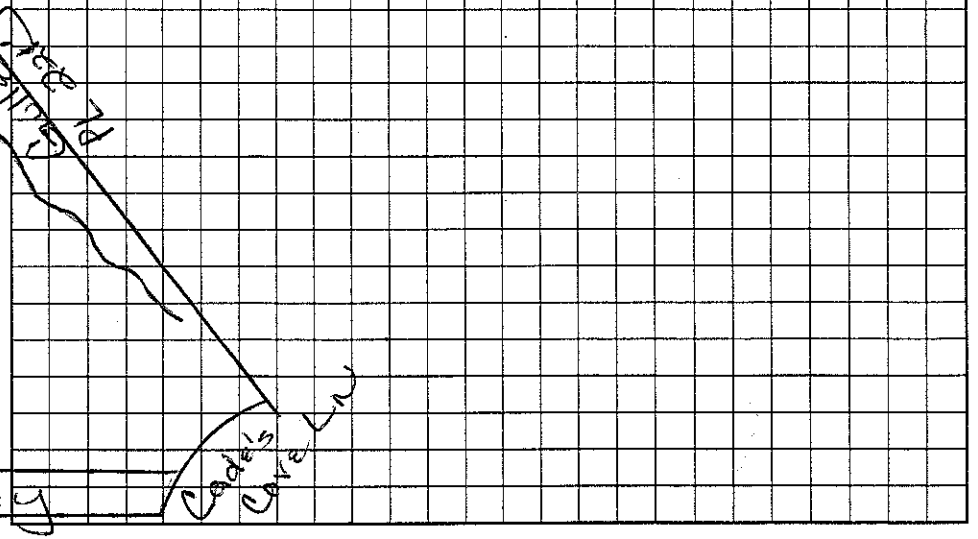

Permit can be suspended or revoked if any false information is supplied toward securing the permit/any unauthorized changes are made to the site/any unauthorized changes are made in the installation of the system. Improvement Permit with plat valid without expiration. Improvement Permit with site plan valid for sixty months. Authorization to Construct is valid for a period equal to that of Improvement Permit – not to exceed sixty months.

Signed: Lloyd E Hartman date 5/21/01 Installed by: Curt Dunning

Improvement Permit by: Maria H.H. Dotson RS date 4/16/2001 Operation Permit by: Wesley Sparks RS date 1/16/02

Authorization to Construct by: Maria H.H. Dotson RS date 4/16/2001 Existing System Inspection by: date

HEALTH DEPT. COPY: WHITE OWNER COPY (FINAL): YELLOW OWNER COPY (INITIAL): PINK