IREDELL COUNTY HEALTH DEPARTMENT

AUTHORIZATION TO CONSTRUCT

STATESVILLE 704-878-5305 MOORESVILLE 704-664-5281

IMPROVEMENT PERMIT / ~~CERTIFICATE OF COMPLETION~~ / OPERATION PERMIT / EXISTING SYSTEM INSPECTION

PROPERTY DESCRIPTION NO. 065660 DATE 7/31/97 TAX MAP NO. 4625914684 (pt) Watershed: ☑ Yes ☐ No

OWNER OR CONTRACTOR CRESCENT RESOURCES INC. PHONE: Business _____ Home _____

ADDRESS PO BOX 1003. CHARLOTTE.

LOCATION BRAWLEY SCHOOL RD. TO BAY HARBOUR - TR SHIPYARD PT RL - TR CAVES COVE LN ON RT

SUBDIVISION HARBOR BLOCK / SECTION 6 LOT 7 LOT AREA _____ SITE CLASS. PS DESIGN FLOW 660 L.T.A.R. .3 GPD/FT²

Septic Tank: ~~1000~~ 1500 Gallons; STB 794 Date 5/12/98

Pump Tank: _____ Gallons; PT _____ Date _____

Pump Make: _____ Model _____ Serial No. _____

Nitrification Field: No Fields 1 Square Feet 1500 Linear Feet 500

No Lines 4@125 Trench Width 36" Max Trench Bottom Depth 36" Gravel Depth 6"/N/A

☑ New System ☐ Repair System Type: I II IV, V, VI

System Description: GRAVITY CHAMBERED

Repair System Description: SAME

Maintenance Agreement Required: ☐ Yes ☑ No

☑ House/Mod. Home No. Bedrooms 5

☐ Mobile Home No. Bathrooms 5

☐ Business No. Employees ____

☐ Other _____


☐ Slab ☐ Crawl Space ☑ Basement w/plumbing ☐ Basement wo/plumbing

Water Supply: ☐ Individual ☑ Community ☐ Public


Comments:

Comments:
FIRST LINE FED TO FILL UP AND BACK TO BOX - DROPPING DOWN TO FEED NEXT 3 LINES EQUAL.

INITIAL SITE SKETCH

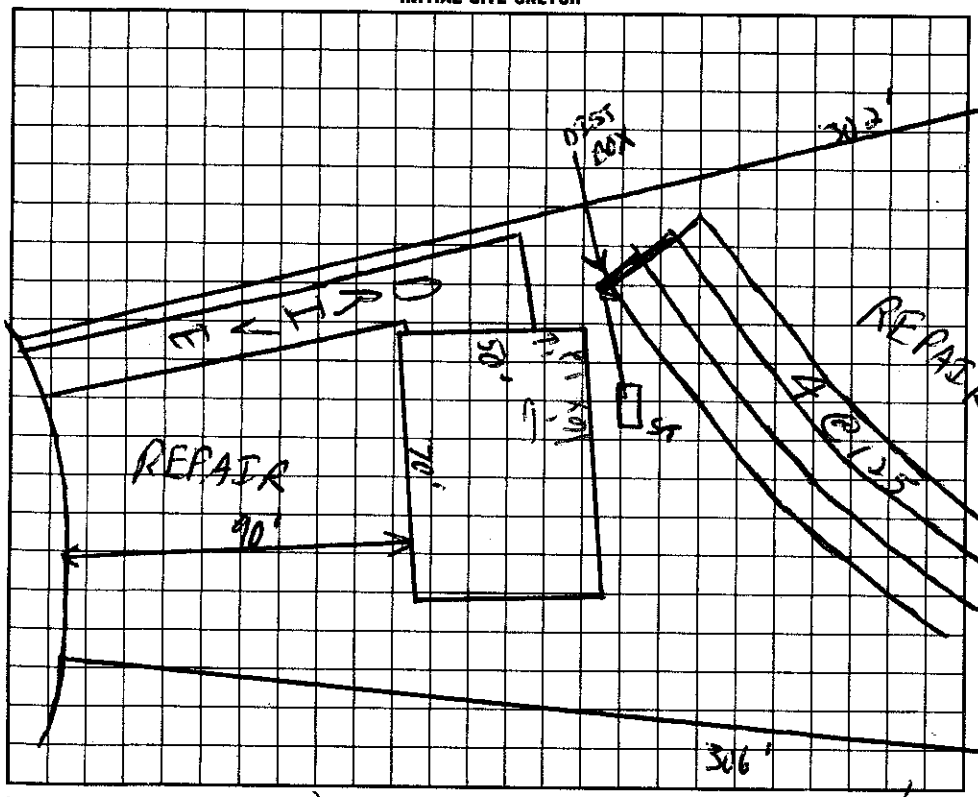

AS BUILT SKETCH

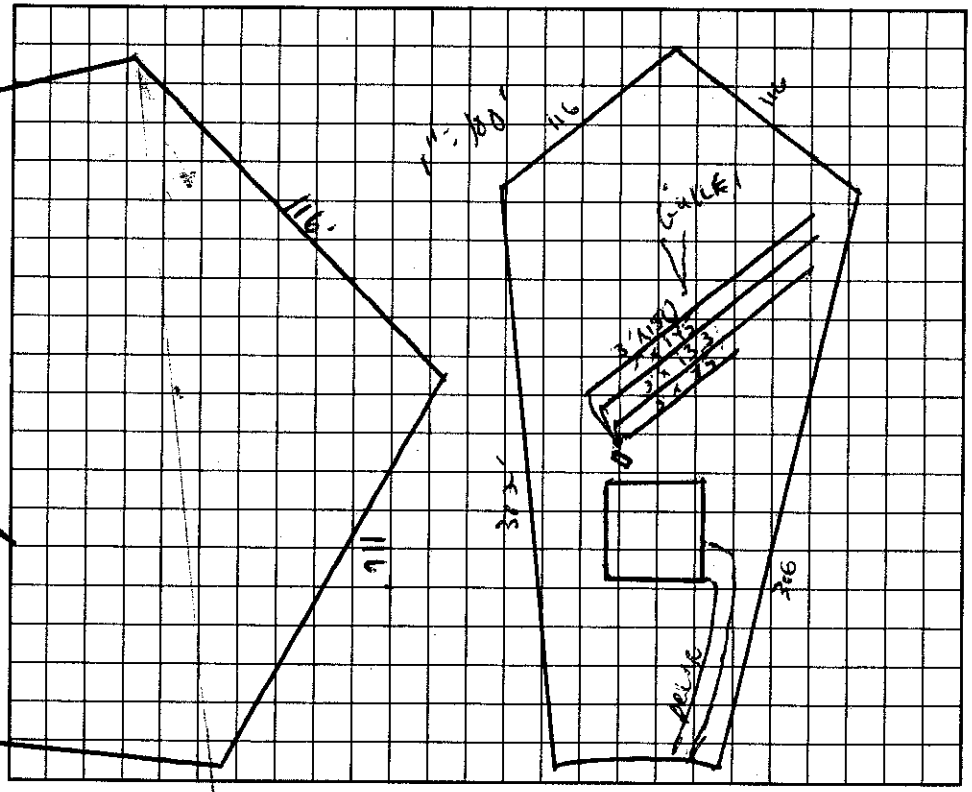

I understand that this permit can be suspended or revoked if any false information is supplied toward securing the permit/any unauthorized changes are made to the site/any unauthorized changes are made in the installation of the system. Improvement ~~Permit~~ is valid for 60 months from date of issuance.

Signed: _____ Agent 4/5/95

Improvement Permit by: _____ date 8/5/97

~~Existing System~~ Authorization to Construct Inspection by: _____ date 5/5/97

Installed by: TERRY JONES

Certificate of Completion by: _____ date _____

Operation Permit by: _____ date 5/14/98

HEALTH DEPT. COPY: WHITE INSPECTION COPY (FINAL): GREEN OWNER COPY (FINAL): YELLOW INSPECTION COPY (INITIAL): PINK OWNER COPY (INITIAL): GOLD