IREDELL COUNTY HEALTH DEPARTMENT

Coast Auth STATESVILLE 704-878-5305 MOORESVILLE 704-664-5281

IMPROVEMENT PERMIT / ~~CERTIFICATE OF COMPLETION~~ / OPERATION PERMIT / EXISTING SYSTEM INSPECTION

PROPERTY DESCRIPTION NO. 23368 DATE June 17, '96 (Saturday But) TAX MAP NO. part of 2CA3 4626 30 4671 Watershed: ☑ Yes ☐ No

OWNER OR CONTRACTOR ~~Crescent Resources Inc~~ PHONE Business _____ Home _____

ADDRESS PO Box 1003 Charlotte

LOCATION Brawley Sch Rd. TR Chuckwood TL Morrow's Ridge TR Lake Spring Loop TR Windy Knoll on left in cul-d-Sac

SUBDIVISION The Harbour BLOCK / SECTION III LOT 38 LOT AREA > 20,000 ft² SITE CLASS. PSpec, 1&2 DESIGN FLOW 480gpd L.T.A.R. .3

Septic Tank: 1000 Gallons; STB 794 Date 4/20/97

Pump Tank: 1000 Gallons; PT 27 Date 5/29/97

Pump Make: ~~Jacuzzi~~ ZOROMATIC Model _____ Serial No. _____

Nitrification Field: No Fields 1 Square Feet 1200 Linear Feet 400

No Lines 4@100' Trench Width 36" Max Trench Bottom Depth 36"

☑ New System ☐ Repair System Type: I, II, (III), IV, V, VI

System Description: pumped-pressure-chambered

Repair System Description: LP panel block

Maintenance Agreement Required: ☐ Yes ☑ No

Gravel Depth NA

☑ House/Mod. Home No. Bedrooms 4

☐ Mobile Home No. Bathrooms 4

☐ Business No. Employees _____

☐ Other _____

☐ Slab ☐ Crawl Space ☑ Basement w/plumbing ☐ Basement wo/plumbing


Water Supply:
☐ Individual
☐ Community
☑ Public

Comments: Drainfield in septic field easement "J"

4@100' chambered

Comments: PUMP NOT LARGE ENOUGH- 7/21/97

INITIAL SITE SKETCH

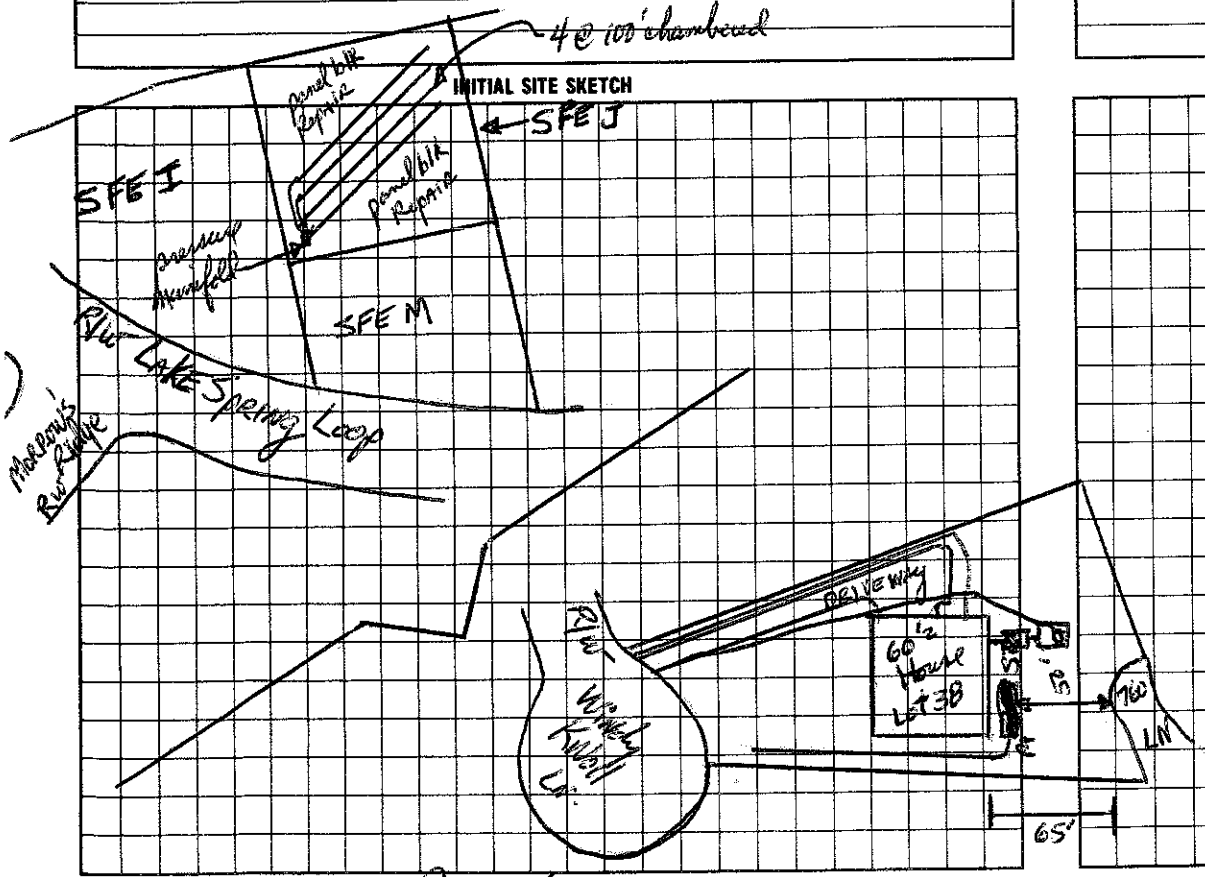

AS BUILT SKETCH

I understand that this permit can be suspended or revoked if any false information is supplied toward securing the permit/any unauthorized changes are made to the site/any unauthorized changes are made in the installation of the system.

Signed: _____

Improvement Permit by: _____ date 6-17-96

~~Construction~~ Existing System Inspection by: _____ date 12/3/96

Authorization

Installed by: MacLeod Const.

Certificate of Completion by: Wesley Sparks RS. date 8/18/97

Operation Permit by: Wesley Sparks RS. date 8/18/97

HEALTH DEPT. COPY: WHITE INSPECTION COPY (FINAL): GREEN OWNER COPY (FINAL): YELLOW INSPECTION COPY (INITIAL): PINK OWNER COPY (INITIAL): GOLD