4626-30-4701

IREDELL COUNTY HEALTH DEPARTMENT

Const. Auth. STATESVILLE 704-878-5305 MOORESVILLE 704-664-5281

IMPROVEMENT PERMIT / ~~CERTIFICATE OF COMPLETION~~ / OPERATION PERMIT / EXISTING SYSTEM INSPECTION

PROPERTY DESCRIPTION NO. 23367 DATE June 17 '96 TAX MAP NO. part of 2CA3 ~~4626-30-4701~~ Watershed: ☑ Yes ☐ No

OWNER OR CONTRACTOR Crescent Resources Corp (SAM SSY BURBANK) PHONE Business _____ Home _____

ADDRESS PO Box 1003 Charlotte

LOCATION Brawley Sch Rd TR Churchwood TL Morrows Ridge TR Lake Spring Loop TR Windy Knoll AT END

SUBDIVISION The Harbour BLOCK / SECTION III LOT 37 LOT AREA 2½,000 ft² SITE CLASS. P3 per 1953 DESIGN FLOW 480gpd L.T.A.R. .3

Septic Tank: 1000 Gallons; STB 794 Date 6/11/98

Pump Tank: 1000 Gallons; PT 27 Date 6/10/98

Pump Make: SKHD 150M2 Model HYDROMATIC Serial No. 3/98

Nitrification Field: No Fields 1 Square Feet 1200 Linear Feet 400

No Lines ~~4 @ 100'~~ Trench Width 36" Max Trench Bottom Depth 36" Gravel Depth N/A

☑ New System ☐ Repair System Type: I, II, III, IV, V, VI

System Description: pumped - pressure - chambered

Repair System Description: same

Maintenance Agreement Required: ☐ Yes ☑ No

☑ House/Mod. Home No. Bedrooms 4

☐ Mobile Home No. Bathrooms 4

☐ Business No. Employees ____

☐ Other ____


☐ Slab ☐ Crawl Space ☑ Basement w/plumbing ☐ Basement wo/plumbing

Water Supply: ☐ Individual ☐ Community ☑ Public


Comments: 5@ 80'x3' 4@100' chambered Pressure manifold SFE K Drainfield in septic field easement "K"

Comments:

INITIAL SITE SKETCH 1" = 100'

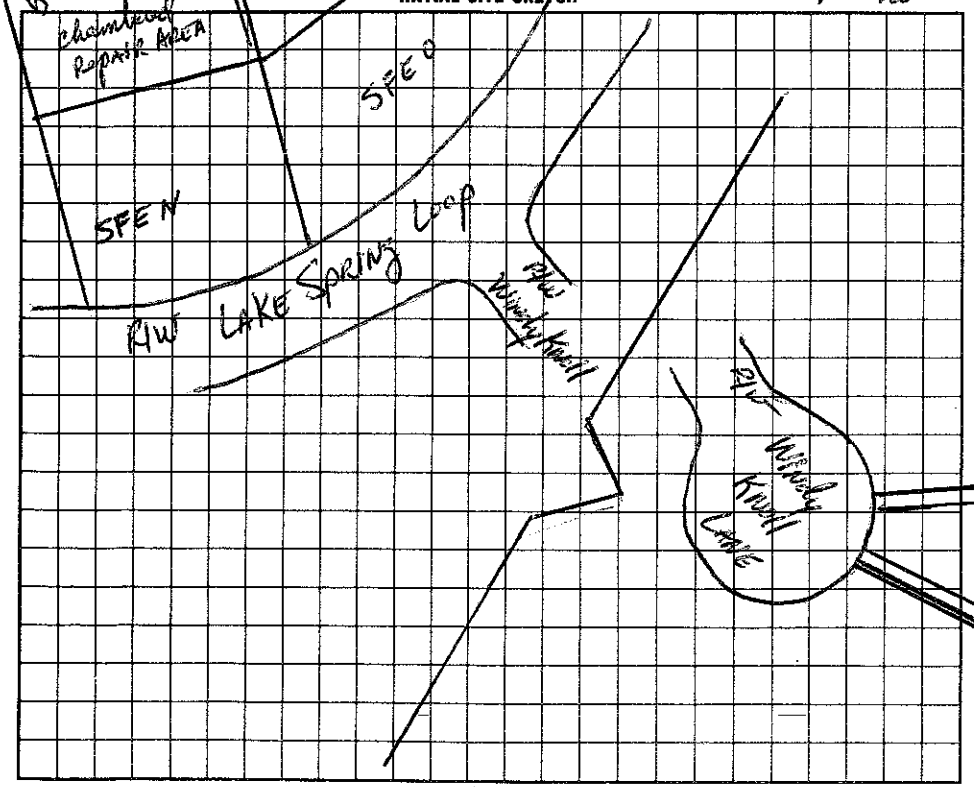

AS BUILT SKETCH

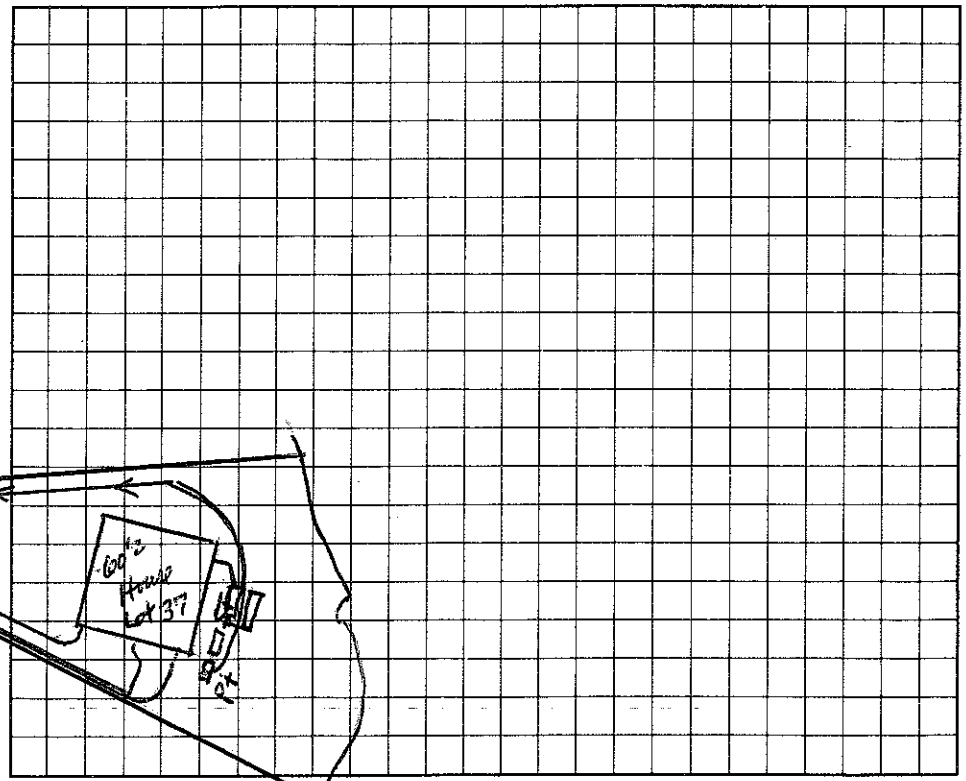

I understand that this permit can be suspended or revoked if any false information is supplied toward securing the permit/any unauthorized changes are made to the site/any unauthorized changes are made in the installation of the system.

Signed: ~~X~~ Tony C. Burbank, CPSS

Improvement Permit by: Steve B. Hinson RS date 6-17-96

~~Existing System Inspection by:~~ Construction Wesley Sparks RS. date 2/11/98

Installed by: MacLeod Const.

Certificate of Completion by: Wesley Sparks RS. date 10/12/98

Operation Permit by: Wesley Sparks RS. date 10/12/98

~~Authorized~~

HEALTH DEPT. COPY: WHITE INSPECTION COPY (FINAL): GREEN OWNER COPY (FINAL): YELLOW INSPECTION COPY (INITIAL): PINK OWNER COPY (INITIAL): GOLD