# IREDELL COUNTY HEALTH DEPARTMENT Const. Auth. STATESVILLE 704-878-5305 MOORESVILLE 704-664-5281

## IMPROVEMENT PERMIT / ~~CERTIFICATE OF COMPLETION~~ / OPERATION PERMIT / EXISTING SYSTEM INSPECTION

PROPERTY DESCRIPTION NO. 23366 DATE June 17, 196 TAX MAP NO. Part of 2CA3 4626-30-4813 Watershed: ☑ Yes ☐ No

OWNER OR CONTRACTOR Crescent Resources Inc (SAMSSY BURBANK) PHONE: Business _____ Home _____

ADDRESS PO Box 1003, Charlotte

LOCATION Brawley School Rd. TR Chuckwood TR Monroes Ridge TR Lake Spring TR Windy Knoll at end

SUBDIVISION The Harbors BLOCK / SECTION III LOT 36 LOT AREA +22,000 ft² SITE CLASS. B pen. 1996 DESIGN FLOW 480 gpd L.T.A.R. .3

Septic Tank: 1000 Gallons; STB 794 Date 11/4/97

Pump Tank: 1000 Gallons; PT 27 Date 1/2/98

Pump Make: NORO. Model SHEF100M2 Serial No. 12/98

Nitrification Field: No Fields 1 Square Feet 1200 Linear Feet 400

No Lines 3@133' Trench Width 36" Max Trench Bottom Depth 36" Gravel Depth N/A

☑ New System ☐ Repair System Type: I, II, III, IV, V, VI

System Description: pumped-pre-chamber

Repair System Description: Same

Maintenance Agreement Required: ☐ Yes ☑ No

☑ House/Mod. Home No. Bedrooms 4/4

☐ Mobile Home No. Bathrooms

☐ Business No. Employees

☐ Other


☐ Slab ☐ Crawl Space ☑ Basement w/plumbing ☐ Basement wo/plumbing

Water Supply: ☐ Individual ☐ Community ☑ Public


Comments: Drainfield in off site septic field easement "0".

Comments:

**INITIAL SITE SKETCH**

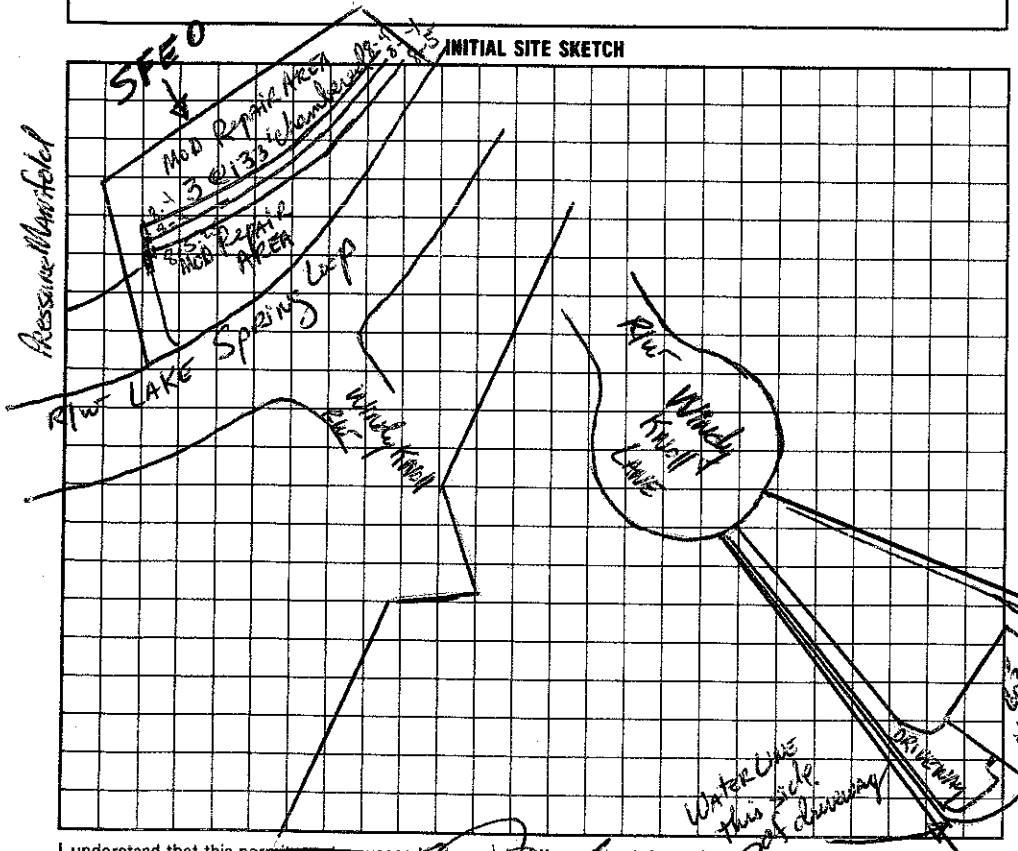


**AS BUILT SKETCH**

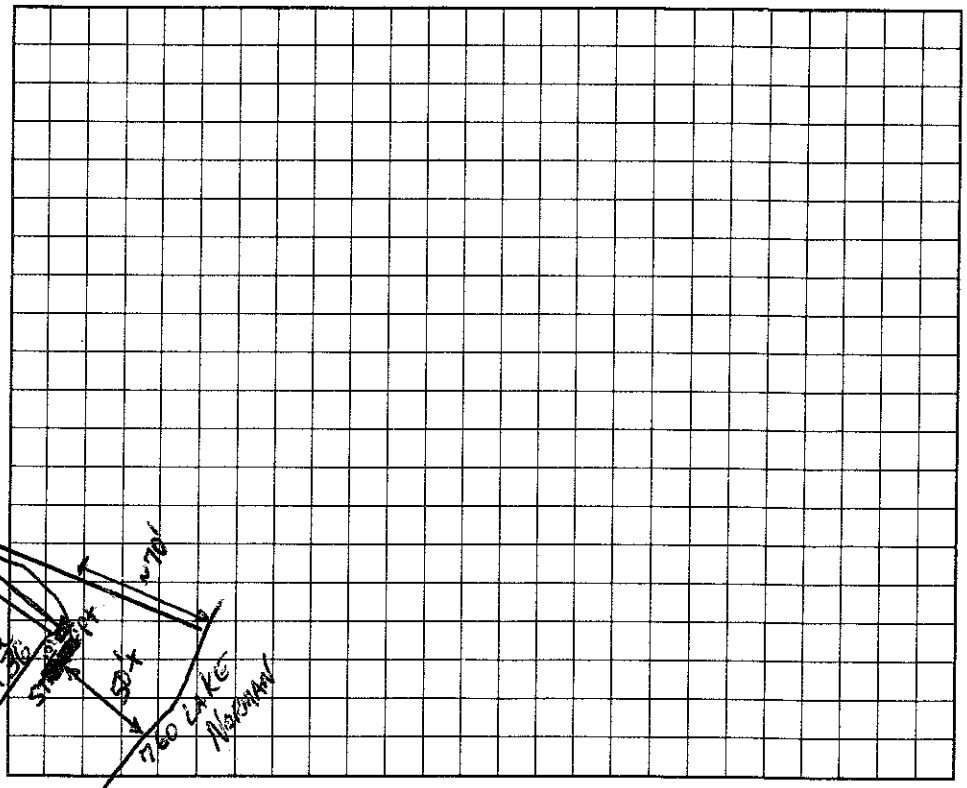


I understand that this permit can be suspended or revoked if any false information is supplied toward securing the permit/any unauthorized changes are made to the site/any unauthorized changes are made in the installation of the system.

Signed: _____

Improvement Permit by: Harold Hanson RS date 6-17-96

Construction Authorization

~~Existing System Inspection by:~~ Wesley Sparks RS. date 7/10/98

Installed by: MacLeod Const.

Certificate of Completion by: Wesley Sparks RS. date 3/19/99

Operation Permit by: _____ date _____

HEALTH DEPT. COPY: WHITE INSPECTION COPY (FINAL): GREEN OWNER COPY (FINAL): YELLOW INSPECTION COPY (INITIAL): PINK OWNER COPY (INITIAL): GOLD