IREDELL COUNTY HEALTH DEPARTMENT Coast Auth. STATESVILLE 704-878-5305 MOORESVILLE 704-664-5281

IMPROVEMENT PERMIT / ~~CERTIFICATE OF COMPLETION~~ / OPERATION PERMIT / EXISTING SYSTEM INSPECTION

PROPERTY DESCRIPTION NO. 23365 DATE June 14, 196 TAX MAP NO. part of 2CA3 4626-30-4981 Watershed: ☑ Yes ☐ No

OWNER OR CONTRACTOR Crescent Resources Inc / Sallie Burbank PHONE: Business _____ Home _____

ADDRESS PO Box 1003, Charlotte,

LOCATION Brawley Sch Rd. TR Chickwood TL Morrow's Ridge TR Lake Spring TR Windy Knoll at End

SUBDIVISION The Harbour BLOCK / SECTION III LOT 35 LOT AREA ≥ 20,000 ft² SITE CLASS. B pre 1956 DESIGN FLOW 480 gpd L.T.A.R. .3

Septic Tank: 1000 Gallons; STB 794 Date 2/10/99

Pump Tank: 1000 Gallons; PT 29 Date 3/3/99

Pump Make: HYDROMATIC Model SHEF100A2 Serial No. 12198

Nitrification Field: No Fields 1 Square Feet 1200 Linear Feet 400

No Lines 4 @ 100' Trench Width 36" Max Trench Bottom Depth 30" Gravel Depth NA

☑ New System ☐ Repair System Type: I, II, (III), IV, V, VI

System Description: pumped-pre-chambered

Repair System Description: LP Panel Blocks

Maintenance Agreement Required: ☐ Yes ☑ No

☑ House/Mod. Home ☐ Mobile Home ☐ Business ☐ Other

No. Bedrooms 3/4 No. Bathrooms 3/4 No. Employees ____


☐ Slab ☐ Crawl Space ☑ Basement w/plumbing ☐ Basement wo/plumbing

Water Supply: ☐ Individual ☐ Community ☑ Public

Comments:

Comments: Tanks relocated to left rear corner - drive on Right side of lot

INITIAL SITE SKETCH

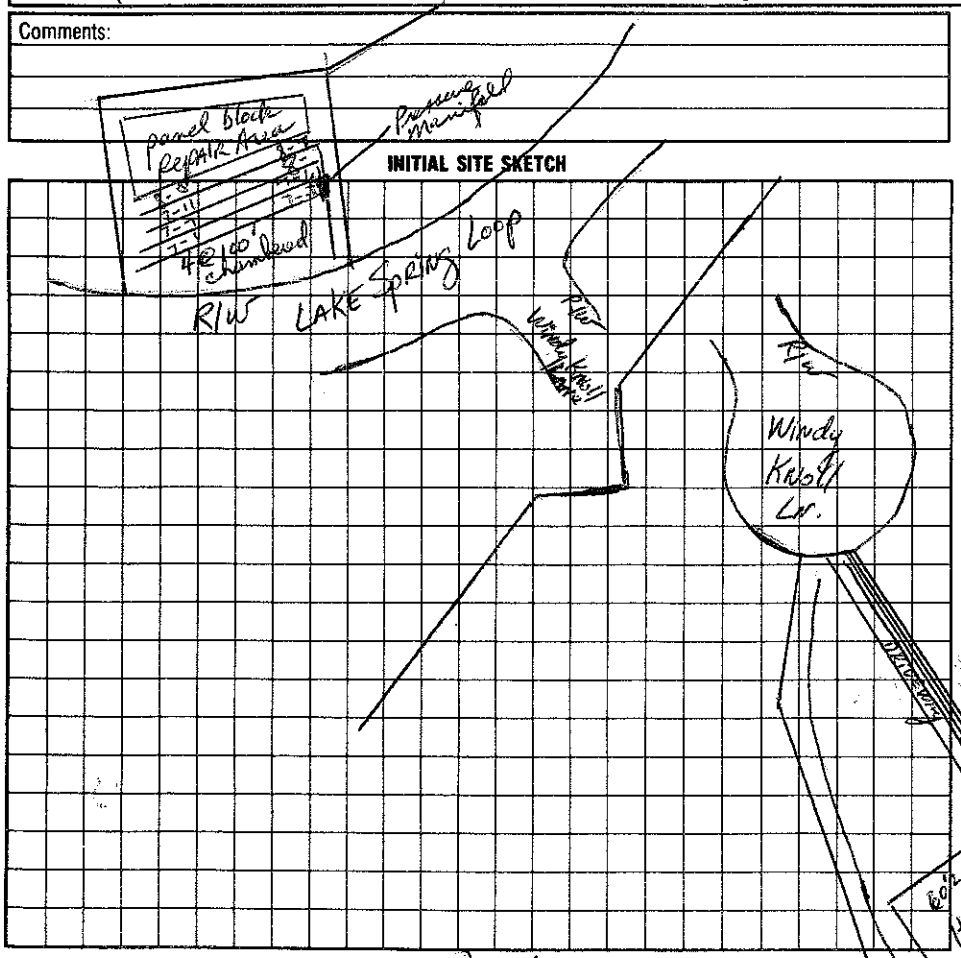

AS BUILT SKETCH

5/4/99 House already occupied on this date based on "TEMPORARY C/O" ISSUED BY IREDELL INSPECTION DEPT. - W. SPARKS

I understand that this permit can be suspended or revoked if any false information is supplied toward securing the permit/any unauthorized changes are made to the site/any unauthorized changes are made in the installation of the system.

Signed: _____

Improvement Permit by: _____ date 6-14-96

~~Existing System Inspection~~ Construction by: Wesley Sparks RS date 5/11/98

Installed by: MacLeod Const.

Certificate of Completion by: Wesley Sparks RS date 5/5/99

Operation Permit by: Wesley Sparks RS date 5/5/99

HEALTH DEPT. COPY: WHITE INSPECTION COPY (FINAL): GREEN OWNER COPY (FINAL): YELLOW INSPECTION COPY (INITIAL): PINK OWNER COPY (INITIAL): GOLD