IREDELL COUNTY HEALTH DEPARTMENT

STATESVILLE 704-878-5305 MOORESVILLE 704-664-5281

IMPROVEMENT PERMIT / AUTHORIZATION TO CONSTRUCT / OPERATION PERMIT / EXISTING SYSTEM INSPECTION

PERMIT# 23364 PIN# ~~4643~~ 4646030597 DATE 7/14/98

OWNER OR CONTRACTOR Gregory Barbour PHONE: Business Home

ADDRESS 517 Sharon Amity Rd. Charlotte, NC. 28211

LOCATION Brawley Sch Rd. TR Chuckwood TL Morrows Ridge TR Lake Spring TR Windy Knoll Lane, at end.

SUBDIVISION HARBOUR BLOCK / SECTION III LOT 34 LOT AREA .83 SITE CLASS. PS DESIGN FLOW 480 L.T.A.R. .5

Septic Tank: 1000 Gallons; STB 794 Date 4/17/99

Pump Tank: 1000 Gallons; PT 27 Date 5/7/99

Pump Make: HYDROMATIC Model SHEF 50A4 Serial No. 5/5/99

Nitrification Field: No Fields 1 Square Feet 825 Linear Feet 275 ✱

No Lines 5 @ 55' Trench Width 36" Max Trench Bottom Depth 30" Gravel Depth SAND.

☒ New System ☐ Repair System Type: I, II, III, (IV) V, VI

System Description: LP - PPBS 16"

Repair System Description: SAME

Maintenance Agreement Required: ☒ Yes ☐ No

☒ House/Mod. Home No. Bedrooms 4

☐ Mobile Home No. Bathrooms 4

☐ Business No. Employees

☐ Other


☐ Slab ☐ Crawl Space ☒ Basement w/plumbing ☐ Basement wo/plumbing

Water Supply: ☐ Individual ☐ Public ☒ Community


Comments:/Conditions: ✱ 50% reduction for 16" PPBS use
Use 36" wide trenches
63 panels = 195 GAL/DOSE
38-32 GPM 5" Tether

Comments:/Conditions:

INITIAL SITE SKETCH

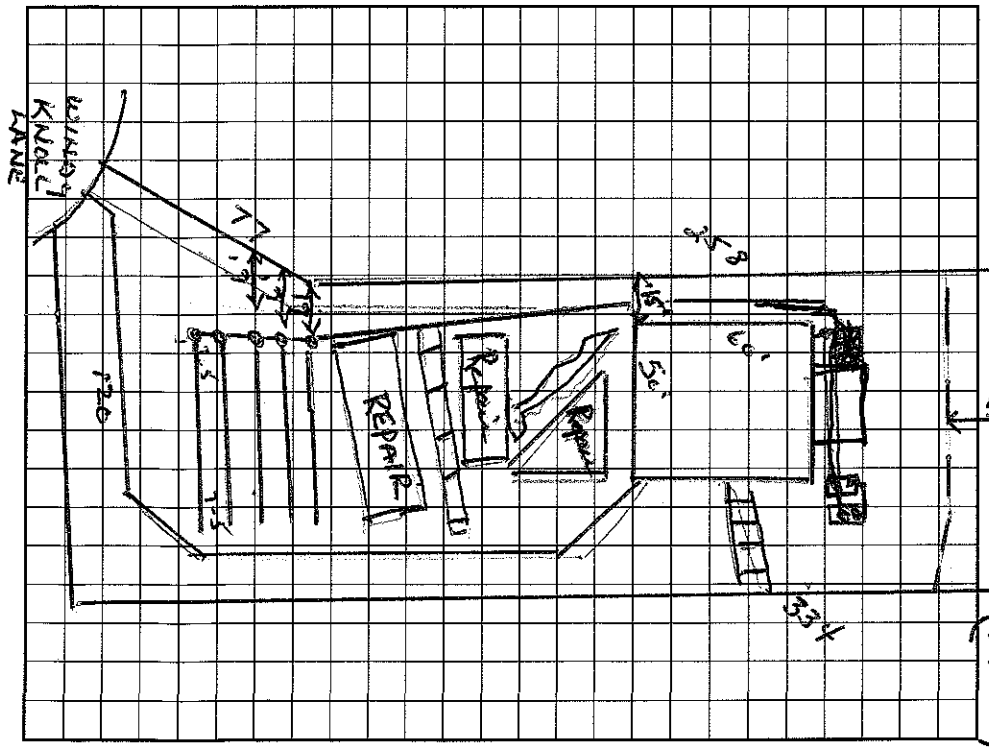

AS BUILT SKETCH

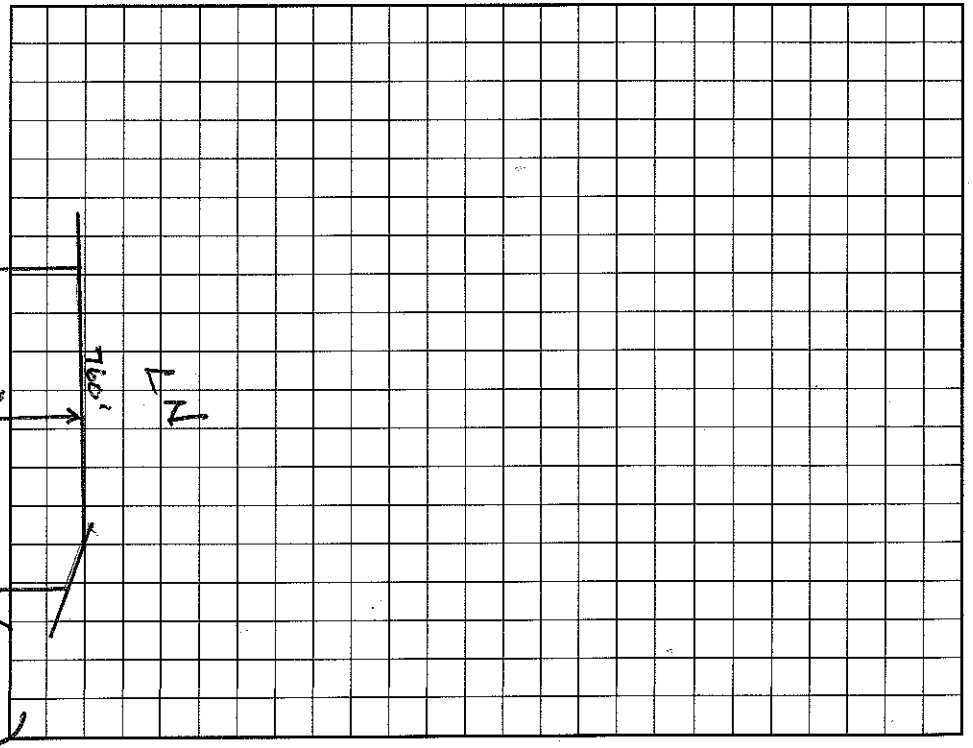

I understand that this permit can be suspended or revoked if any false information is supplied toward securing the permit/any unauthorized changes are made to the site/any unauthorized changes are made in the installation of the system. Improvement Permit with plat valid without expiration. Improvement Permit with site plan valid for sixty months. Authorization to Construct is valid for a period equal to that of Improvement Permit – not to exceed sixty months.

Signed: ✱ ~~Wesley Sparks~~ date 7/17/98 Installed by: MacLee & Const.

Improvement Permit by: Wesley Sparks R.S. date 7/14/98 Operation Permit by: Wesley Sparks R.S. date 6/22/99

Authorization to Construct by: Wesley Sparks R.S. date 7/14/98 Existing System Inspection by: date

HEALTH DEPT. COPY: WHITE INSPECTION COPY (FINAL): GREEN OWNER COPY (FINAL): YELLOW INSPECTION COPY (INITIAL): PINK OWNER COPY (INITIAL): GOLD