IREDELL COUNTY HEALTH DEPARTMENT

Court Auth. STATESVILLE 704-878-5305 MOORESVILLE 704-664-5281

664-9879

IMPROVEMENT PERMIT / ~~CERTIFICATE OF COMPLETION~~ / OPERATION PERMIT / EXISTING SYSTEM INSPECTION

PROPERTY DESCRIPTION NO. 065615 DATE July 8, '97 TAX MAP NO. 4625941684 (pt.) 4626 30 6052 Watershed: ☑ Yes ☐ No

OWNER OR CONTRACTOR Crescent Resources Llc / K Heffner PHONE: Business _____ Home _____ WSIICA

ADDRESS PO Box 1003, Charlotte

LOCATION Brawley Sch Rd. TR Bay Harbour on Right before jct w/ Shipyard PO. 334 Bay Harbour Rd

SUBDIVISION The Harbour BLOCK / SECTION 6 LOT 1 LOT AREA 1 Ac± SITE CLASS. PS DESIGN FLOW 480 gpd L.T.A.R. .3 initially / .25 Repair

Septic Tank: 1000 Gallons; STB 794 Date 3-16-01

Pump Tank: 1000 Gallons; PT 27 Date 3-25-00

Pump Make: _____ Model _____ Serial No. _____

Nitrification Field: No Fields 1 Square Feet 1800 Linear Feet 400

No Lines 5@80 (Trench Width 36" Max Trench Bottom Depth 24" Gravel Depth N/A

☑ New System ☐ Repair

System Type: I, II, III, IV, V, VI

System Description: pumped-to-chambered LPP / modified Panel

Repair System Description LPP / modified Panel

Maintenance Agreement Required: ☐ Yes ☑ No initially

☑ House/Mod. Home ☐ Mobile Home ☐ Business ☐ Other

No. Bedrooms 4 No. Bathrooms 4 No. Employees _____

☐ Slab ☑ Crawl Space ☐ Basement w/plumbing ☑ Basement wo/plumbing


Water Supply: ☐ Individual ☑ Community ☐ Public

Comments: Low lot


Comments: laterals checked, checked lines - Lines need to be shortened to meet 25' setback to basement, extra line will be added. Pres checked 5/15/2001 JK 5/1/200

1"=50'

INITIAL SITE SKETCH

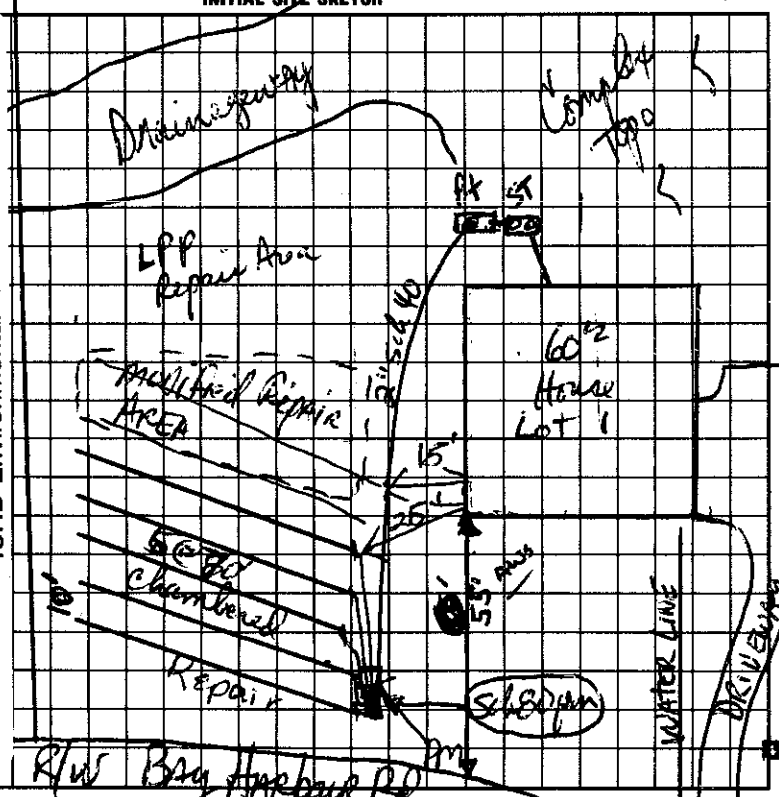

AS BUILT SKETCH

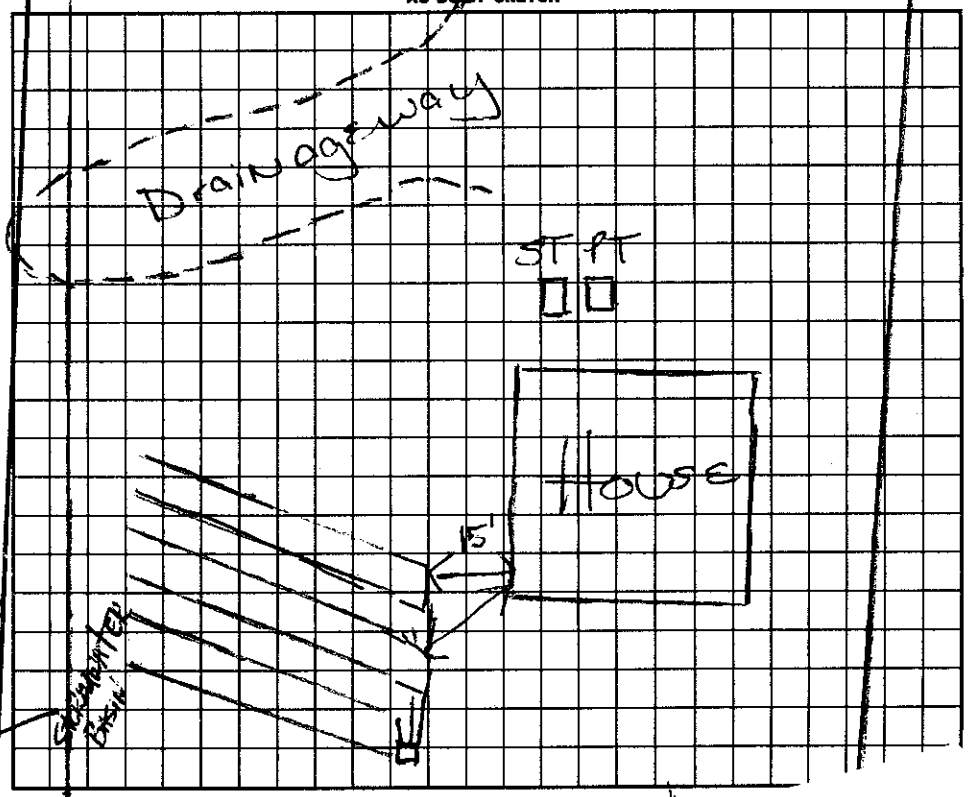

The proposed / existing Repair Addition system does not appear to impact the existing septic system.

**NOTE: _____

Date: 11/20/2000 ICHD-Environmental Health Division

I understand that this permit can be suspended or revoked if any false information is supplied toward securing the permit/any unauthorized changes are made to the site/any unauthorized changes are made in the i
Improvement Permit is valid for 60 months from date of issuance.

Signed: _____

Improvement Permit by: _____ date 7-8-97

~~As-Built System Inspection by:~~ Wesley Sparks R.S. date 11/16/00

Installed by: R&H Bay Harbor

Certificate of Completion by: Maria Dotson

Operation Permit by: _____

5-29-01

CONSTRUCTION

Eliza Taylor

HEALTH DEPT. COPY: WHITE INSPECTION COPY (FINAL): GREEN OWNER COPY (FINAL): YELLOW INSPECTION COPY (INITIAL): PINK