IREDELL COUNTY HEALTH DEPARTMENT

STATESVILLE 704-878-5305 MOORESVILLE 704-664-5281

IMPROVEMENT PERMIT / AUTHORIZATION TO CONSTRUCT / OPERATION PERMIT / EXISTING SYSTEM INSPECTION

PERMIT # 160270 PIN # 4626306052 DATE 3/19/10

OWNER or APPLICANT Pelican Pools & Spas / Johnathan Bosnett PHONE: Business Home: 980-722-7199

OWNER or APPLICANT ADDRESS 19706 one Norman Blvd Suite 213, Cornelius NC

LOCATION / DIRECTIONS Williamson Rd (L) Brawley School Rd (R) Bay Harbor

SUBDIVISION The Harbor BLOCK / SECTION C LOT # 1 LOT AREA 1.28 ACRES DESIGN FLOW existing L.T.A.R. existing

Septic Tank existing Gallons: STB existing Date
Pump Tank existing Gallons: PT existing Date
Pump Make Model Serial #
Nitrification Field No Fields 1 No Lines Linear Feet 460 existing
Trench Width Max. Trench Bottom Depth Gravel Depth


☐ New System ☐ Repair ☐ Expansion System Type I II (III) IV V VI
System Description: existing pumped chambered
Repair System Description:
Maintenance Agreement Required ☐ YES ☑ NO initially
☐ GRAVITY ☐ PRESSURE

☑ Residence No. Bedrooms 4
☐ Business No. Persons
☐ Other No. Employees
☐ Slab ☐ Crawl Space
☐ Basement w/plumbing ☐ Basement w/o plumbing

Water Supply
☐ Private
☐ Public
☑ Community


Comments / Conditions 1" = 50'

INITIAL SITE SKETCH

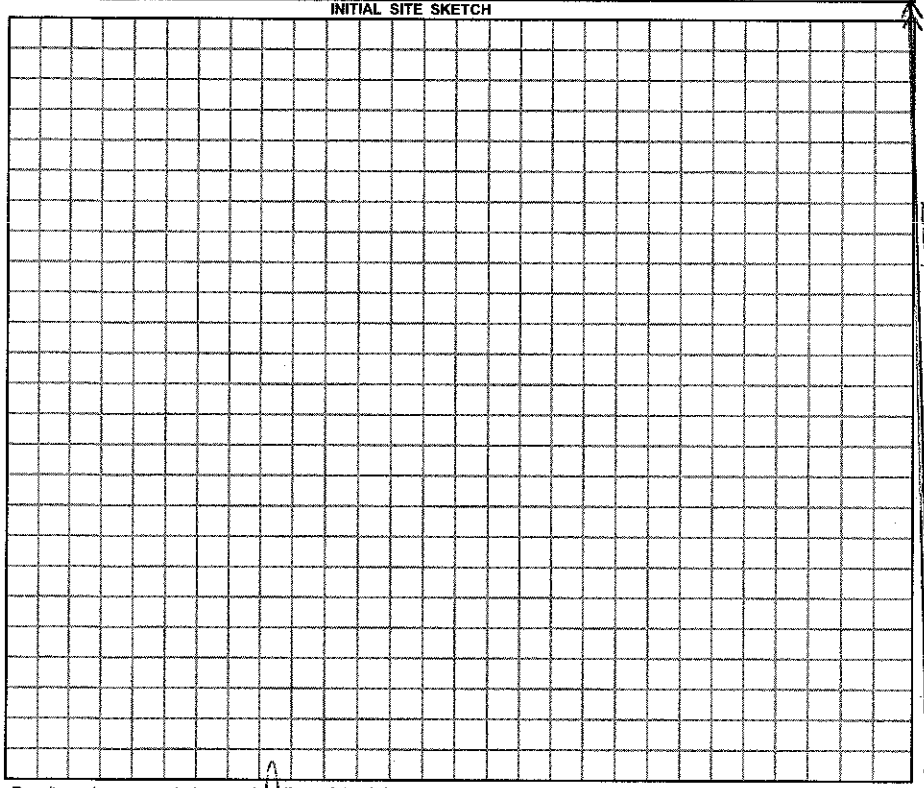

Comments / Conditions Existing system inspection completed for proposed pool. Maintain all setback requirements. existing septic system appears to be functioning properly at time of inspection.

AS BUILT SKETCH

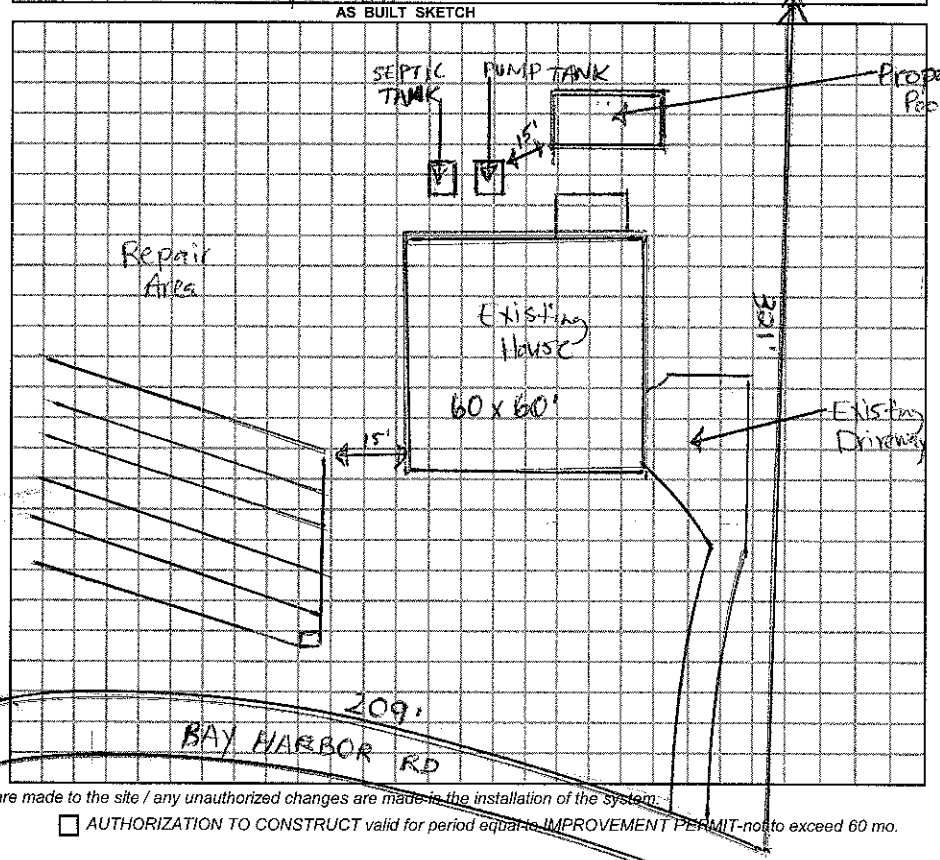

Permit can be suspended or revoked if any false information is supplied toward securing the permit / any unauthorized changes are made to the site / any unauthorized changes are made in the installation of the system.

☐ *IMPROVEMENT PERMIT w / plat valid without expiration.* ☐ *IMPROVEMENT PERMIT w / site plan valid for 60 mos.* ☐ *AUTHORIZATION TO CONSTRUCT valid for period equal to IMPROVEMENT PERMIT-not to exceed 60 mo.*

Owner / Applicant Signature: Date 3/21/10

Improvement Permit by: Date

Authorization to Construct by: Date

YOU SHOULD CONTACT A LOCATOR SERVICE PRIOR TO ANY EXCAVATION.

Installed by:

Operation Permit by: Date:

Existing System Inspected by: Kyle Baker, REHS Date: 3/21/10

WHITE COPY Environmental Health YELLOW COPY (Final) Owner / Applicant PINK COPY (Initial) Owner / Applicant