IREDELL COUNTY HEALTH DEPARTMENT

Const. Auth. STATESVILLE 704-878-5305 MOORESVILLE 704-664-5281

IMPROVEMENT PERMIT / ~~CERTIFICATE OF COMPLETION~~ / OPERATION PERMIT / EXISTING SYSTEM INSPECTION

(3.00)

PROPERTY DESCRIPTION NO. 23712 , 0 DATE: June 10, '96 TAX MAP NO. ~~part of 2FCA 445~~ 4626390 3672 Watershed: ☐ Yes ☐ No

OWNER OR CONTRACTOR: SAUSSY BURBANK PHONE: Business _____ Home _____

ADDRESS PO Box

LOCATION Brawley Harbour TR Lake Spring Loop TR Windy Knoll Ln. on left

SUBDIVISION The Harbour BLOCK/SECTION 111 LOT # 41 1 Ridge Ln TR = 25,600 ft² SITE CLASS. PSpr.Mst DESIGN FLOW 360gpd L.T.A.R. ~3

Septic Tank: 1000 Gallons; STB 794 Date 5/27/98

Pump Tank: 1000 Gallons; PT 27 Date 7/3/98

Pump Make: Sher 50 Model _____ Serial No. SHER50M1

Nitrification Field: No Fields 1 Square Feet 400 Linear Feet 200

No Lines 3 (6) Trench Width 24 Max Trench Bottom Depth 30" Gravel Depth NA

☑ New System ☐ Repair System Type: I, II, III, IV, V, VI

System Description: LPPPBPS

Repair System Description: LPPPBPS

Maintenance Agreement Required: ☑ Yes ☐ No

☐ Slab ☑ Crawl Space ☐ Basement w/plumbing ☐ Basement wo/plumbing

☑ House/Mod. Home No. Bedrooms 3

☐ Mobile Home No. Bathrooms 3

☐ Business No. Employees _____

☐ Other _____


Water Supply:
☐ Individual
☐ Community
☑ Public

Comments: Recommend house be moved 20' further back to help with septic system space.

Comments: Tanks & lines checked. 8/25/98 MD
Driveway Must hug property line.

1" = 50'

INITIAL SITE SKETCH

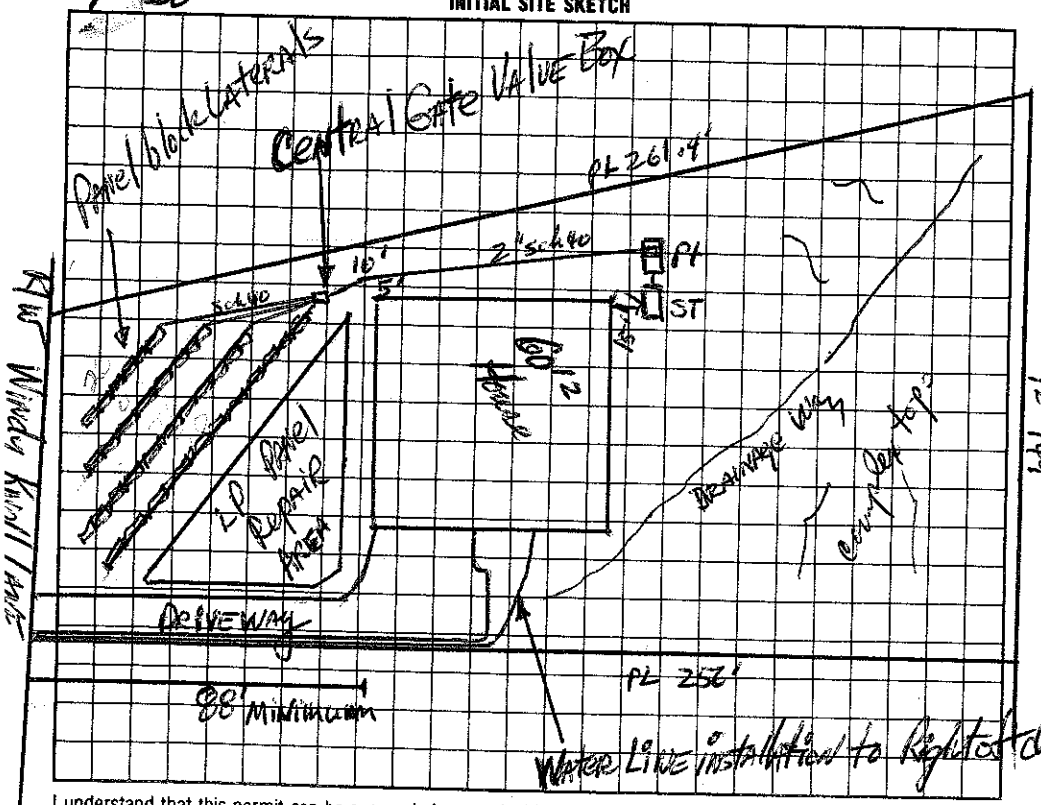

AS BUILT SKETCH

I understand that this permit can be suspended or revoked if any false information is supplied toward securing the permit/any unauthorized changes are made to the site/any unauthorized changes are made in the installation of the system.

Signed: Troy G. Brawley, Owner

Improvement Permit by: Mark Hanson, RS date 6-10-96

Existing System Inspection by: Wesley Sparks R.S. date 10/22/97

Installed by: Macleod Const.

Certificate of Completion by: Wesley Sparks R.S. date 9/10/98

Operation Permit by: Wesley Sparks R.S. date 9/10/98

Authorization

HEALTH DEPT. COPY: WHITE INSPECTION COPY (FINAL): GREEN OWNER COPY (FINAL): YELLOW INSPECTION COPY (INITIAL): PINK OWNER COPY (INITIAL): GOLD