IREDELL COUNTY HEALTH DEPARTMENT Const. Auth. - STATESVILLE 704-878-5305 MOORESVILLE 704-664-5281

IMPROVEMENT PERMIT / ~~CERTIFICATE OF COMPLETION~~ / OPERATION PERMIT / EXISTING SYSTEM INSPECTION

PROPERTY DESCRIPTION NO. 23711 DATE June 10, '96 TAX MAP NO. part of 2FC445 Watershed: ☐ Yes ☐ No

OWNER OR CONTR SAUSSY BURBANK PHONE: Business _____ ~~Home~~ 4626-30-6405

ADDRESS _____

LOCATION Lot 7A SUBDIVISION HARBOUR TTT 40 Brown's Ridge Ln. TR Lake Springs Loop TR Windy Knoll on left

LOT AREA > 25,000 ft² SITE CLASS Rpr. 1957 DESIGN FLOW 360 gpd L.T.A.R. .125

Septic Tank: 1000 Gallons; STB 794 Date 7/20/98

Pump Tank: _____ Gallons; PT _____ Date _____

Pump Make: _____ Model _____ Serial No. _____

Nitrification Field: No Fields 2 Square Feet 480 Linear Feet 240

No Lines 3+3 Trench Width 24" Max Trench Bottom Depth 30" Gravel Depth NA

☑ New System ☐ Repair System Type: I. II. III. IV. V. VI

System Description: GRAVITY PANEL

Repair System Description: LP PANEL

Maintenance Agreement Required: ☐ Yes ☑ No

☑ House/Mod. Home No. Bedrooms 3

☐ Mobile Home No. Bathrooms 3

☐ Business No. Employees _____

☐ Other _____


☐ Slab ☑ Crawl Space ☐ Basement w/plumbing ☐ Basement wo/plumbing

Water Supply: ☐ Individual ☐ Community ☑ Public

Comments:

Comments:

INITIAL SITE SKETCH 1" = 50'

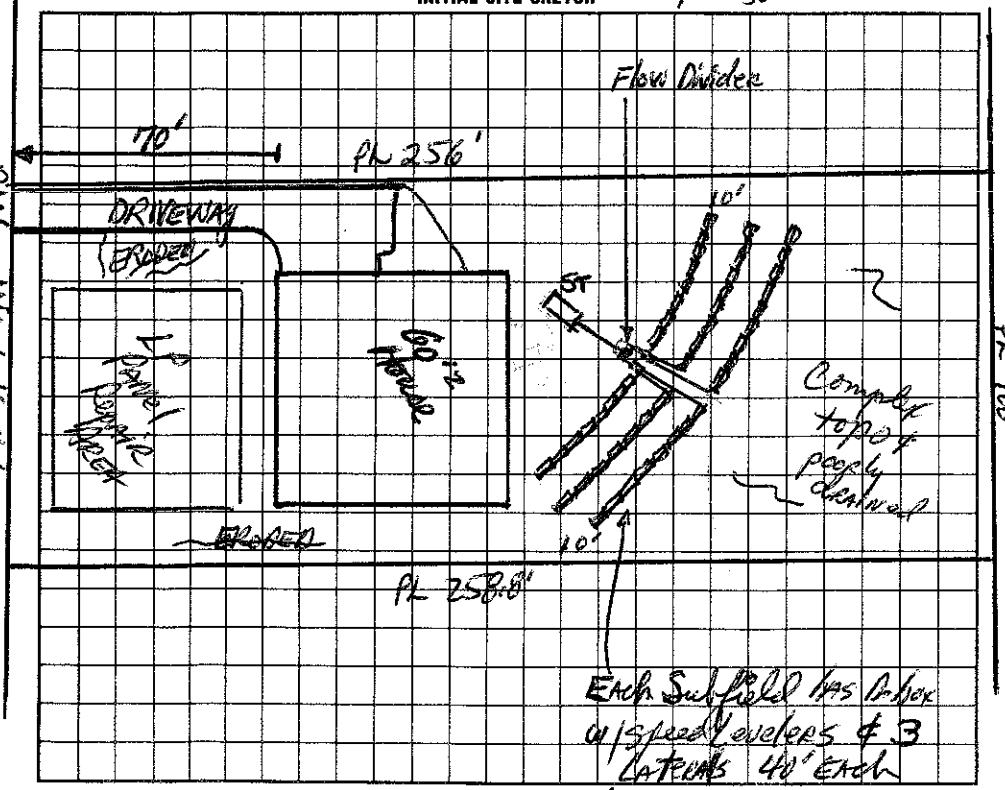

AS BUILT SKETCH

I understand that this permit can be suspended or revoked if any false information is supplied toward securing the permit/any unauthorized changes are made to the site/any unauthorized changes are made in the installation of the system.

Signed: * _____

Improvement Permit by: _____, RS date 6-10-96

~~Construction~~ Existing System Inspection by: _____ R.S. date 10/22/97

Authorization

Installed by: MacLeod Const.

Certificate of Completion by: _____ date _____

Operation Permit by: _____ R.S. date 11/9/98

HEALTH DEPT. COPY: WHITE INSPECTION COPY (FINAL): GREEN OWNER COPY (FINAL): YELLOW INSPECTION COPY (INITIAL): PINK OWNER COPY (INITIAL): GOLD