IREDELL COUNTY HEALTH DEPARTMENT

Authorization to Construct

STATESVILLE 704-878-5305 MOORESVILLE 704-664-5281

IMPROVEMENT PERMIT / ~~CERTIFICATE OF COMPLETION~~ / OPERATION PERMIT / EXISTING SYSTEM INSPECTION

PROPERTY DESCRIPTION NO. 23370 DATE 8/14/97 TAX MAP NO. part of 2CA3 Watershed: X Yes ☐ No

OWNER OR CONTRACTOR Sammy Bumbarger PHONE: Business 365-9916 Home

ADDRESS 6525 Morrison Blvd Charlotte, NC. 28211

LOCATION Brawley Sch TR Chuckwood TL Mayeux Ridge TR Heather Ridge PTR Windy Knoll Ln. on (L)

SUBDIVISION Harbour BLOCK / SECTION III LOT 42 LOT AREA >25,000 FT² SITE CLASS. PS DESIGN FLOW 360 L.T.A.R. .3

Septic Tank: 1000 Gallons; STB 794 Date 9/29/97

Pump Tank: 1000 Gallons; PT 29 Date 10/18/97

Pump Make: Model Serial No.

Nitrification Field: No Fields 1 Square Feet 400 Linear Feet 200*

No Lines 3 Trench Width 24" Max Trench Bottom Depth 30" Gravel Depth STND

☒ New System ☐ Repair System Type: I, II, III, IV, V, VI

System Description: LP PPBS - 16"

Repair System Description: Same

Maintenance Agreement Required: ☒ Yes ☐ No

☒ House/Mod. Home No. Bedrooms 3

☐ Mobile Home No. Bathrooms 3

☐ Business No. Employees

☐ Other


☐ Slab ☒ Crawl Space ☐ Basement w/plumbing ☐ Basement wo/plumbing

Water Supply: ☐ Individual ☒ Community ☐ Public

Comments:

Comments:

INITIAL SITE SKETCH

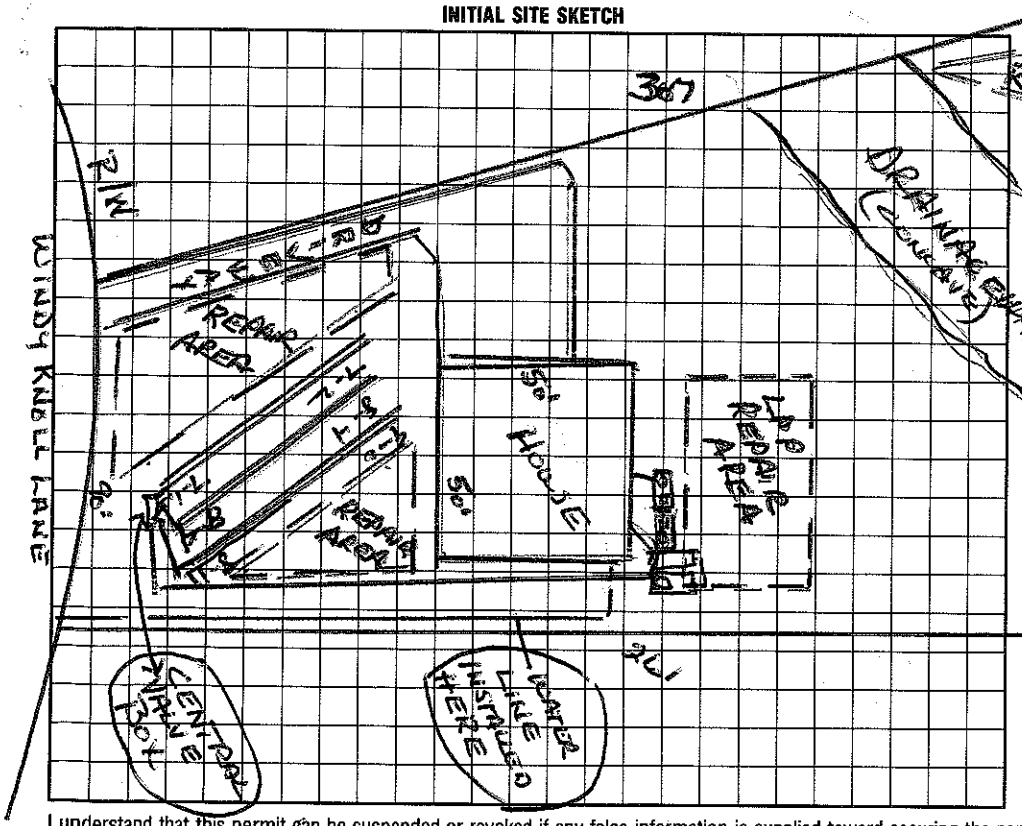

AS BUILT SKETCH

I understand that this permit can be suspended or revoked if any false information is supplied toward securing the permit/any unauthorized changes are made to the site/any unauthorized changes are made in the installation of the system. Improvement Permit is valid for 60 months from date of issuance.

Signed: *

Installed by: Mac Leod Const

Improvement Permit by: Wesley Sparks RS. date 8/14/97

Existing System Inspection by: Wesley Sparks RS date 8/14/97

Certificate of Completion by: date

Operation Permit by: Wesley Sparks RS. date 1/28/98

HEALTH DEPT. COPY: WHITE INSPECTION COPY (FINAL): GREEN OWNER COPY (FINAL): YELLOW INSPECTION COPY (INITIAL): PINK OWNER COPY (INITIAL): GOLD