IREDELL COUNTY HEALTH DEPARTMENT

Statesville Office (704) 878-5305 Mooresville Office (704) 660-3625 PERMIT # 210982 / 210983

IMPROVEMENT PERMIT / AUTHORIZATION TO CONSTRUCT / OPERATION PERMIT / EXISTING SYSTEM

PIN # 4626 307 247

APPLICANT: Encore Bldg Inc APPLICANT ADDRESS: P.O. Box 3995 Mooresville NC

SITE ADDRESS: 113 Windy Knoll Dr Mooresville NC PHONE: ALT. PHONE: 704 746 4531

SITE DIRECTIONS: Brawley School Rd TR Bay Harbor TR Windy Knoll 2nd on left

SUBDIVISION: Bay Harbor SECTION: III LOT # 42 LOT AREA: .810 Ac DESIGN FLOW: 3 bdrm L.T.A.R.: .3

Existing

Septic Tank 1000 (gal) STB Date

Pump Tank 1000 (gal) PT Date

Pump Make Model Serial #

Nitrification Fields 1 # Lines 5 Linear Ft: 308ft

Existing Trench Width 24" - 36" Max. Trench Bottom Depth 36" Gravel Depth N/A

☐ New System ☑ Repair ☐ Expansion System Type: I II III (IV) V VI

System Description: Existing P-PPBPS

Repair System Description: Same

Maintenance Agreement Required: ☒ YES ☐ NO ☐ GRAVITY ☒ PRESSURE

☒ Residence ☐ Business ☐ Other ☐ Slab ☐ Basement w/plumbing

No. Bedrooms 3 No. Persons 6 No. Employees Crawl Space


Water Supply: ☐ Private ☐ Public ☒ Community

☐ Basement w/o plumbing


Comments / Conditions: Must keep any Building at least 5ft from Septic System.

The Proposed Garage And Screened porch does not appear to impact the existing Septic System.

INITIAL SITE SKETCH

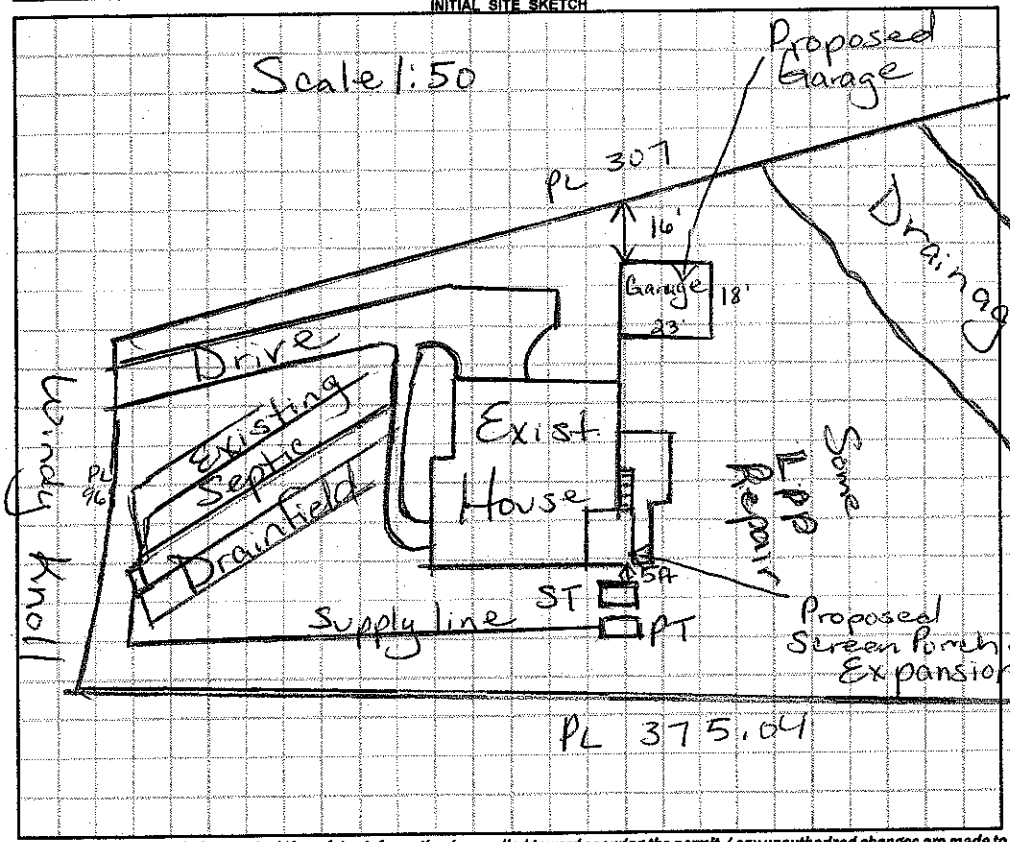

AS BUILT SKETCH

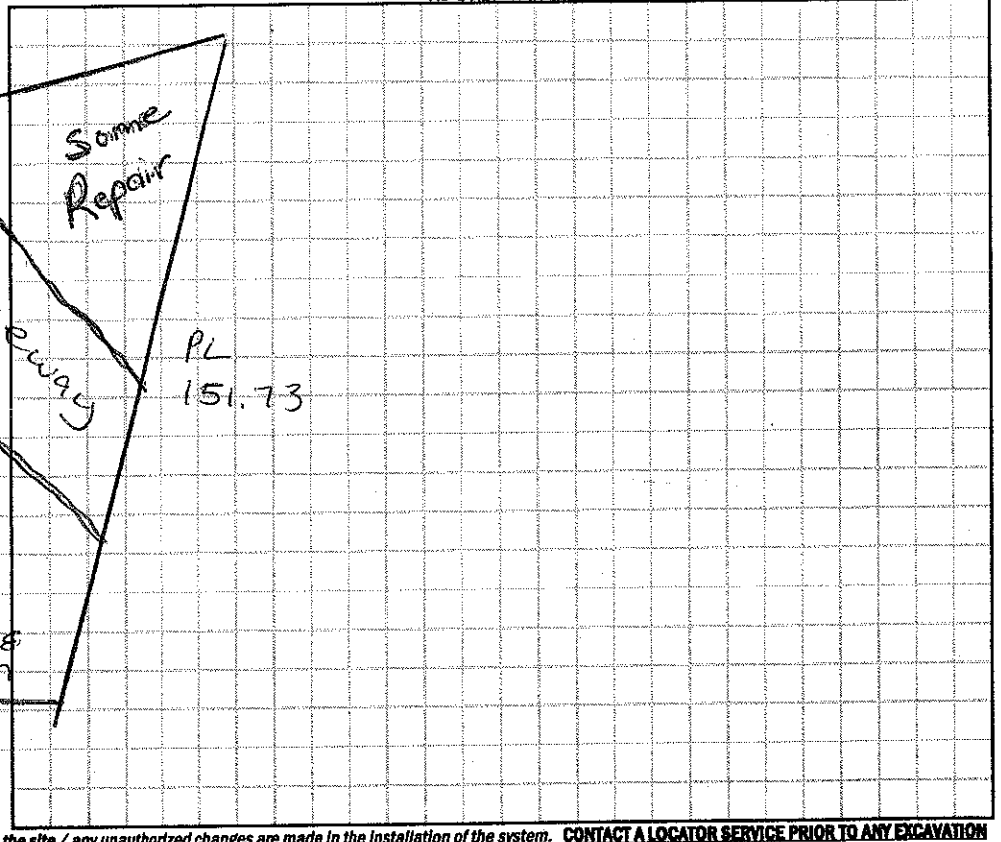

Permit can be suspended or revoked if any false information is supplied toward securing the permit / any unauthorized changes are made to the site / any unauthorized changes are made in the installation of the system. **CONTACT A LOCATOR SERVICE PRIOR TO ANY EXCAVATION**

☐ **IMPROVEMENT PERMIT** *with plan valid without expiration.* ☐ **IMPROVEMENT PERMIT** *with site plan valid for 60 mos.* ☐ **AUTHORIZATION TO CONSTRUCT** *valid for period equal to IMPROVEMENT PERMIT--not to exceed 60 mo.*

Owner / Applicant Signature: Date: 7-28-295 Installed by:

IMPROVEMENT PERMIT by: Date: OPERATION PERMIT by: Date:

AUTHORIZATION TO CONSTRUCT by: Date: Existing System Inspected by: Marie Dotson RS Date: 6/26/15

Health Dept. Copy - WHITE Applicant (Final Approval) - YELLOW Applicant (Conditional Approval) - PINK