IREDELL COUNTY HEALTH DEPARTMENT

Authorization to Construct

STATESVILLE 704-878-5305 MOORESVILLE 704-664-5281

IMPROVEMENT PERMIT / ~~CERTIFICATE OF COMPLETION~~ / OPERATION PERMIT / EXISTING SYSTEM INSPECTION

PROPERTY DESCRIPTION NO. 26267 DATE 3/3/97 TAX MAP NO. ~~4625307755~~ 4624307755 Watershed: [X] Yes [ ] No

OWNER OR CONTRACTOR Sammy Barbanti PHONE: Business 365-9916 Home

ADDRESS 6525 Morrison Blvd. Charlotte NC. 28211

LOCATION Bay Harbour TR Lake Spring TR Windy Knoll Ln. 5th lot on (R)

SUBDIVISION Harbour BLOCK / SECTION III LOT 32 LOT AREA 1.59 ac SITE CLASS. PS DESIGN FLOW 480 L.T.A.R. .3

Septic Tank: 1000 Gallons; STB 994 Date 4/25/97
Pump Tank: 1000 Gallons; PT 27 Date 6/2/97
Pump Make: HYDROMATIC Model SK50A1 Serial No. 3-97
Nitrification Field: No Fields 1 Square Feet *534 Linear Feet *267
No Lines 4 Trench Width 24" Max Trench Bottom Depth 36" Gravel Depth SAND

[X] New System [ ] Repair System Type: I, II, III, (IV), V, VI
System Description: Pres Panel
Repair System Description: Same
Maintenance Agreement Required: [X] Yes [ ] No


[X] House/Mod. Home No. Bedrooms 4
[ ] Mobile Home No. Bathrooms 3
[ ] Business No. Employees
[ ] Other
[ ] Slab [X] Crawl Space [ ] Basement w/plumbing [ ] Basement wo/plumbing

Water Supply:
[ ] Individual
[X] Community
[ ] Public


Comments: * 50% reduction for use of 16" Prefab. Panel Block

Comments:

INITIAL SITE SKETCH

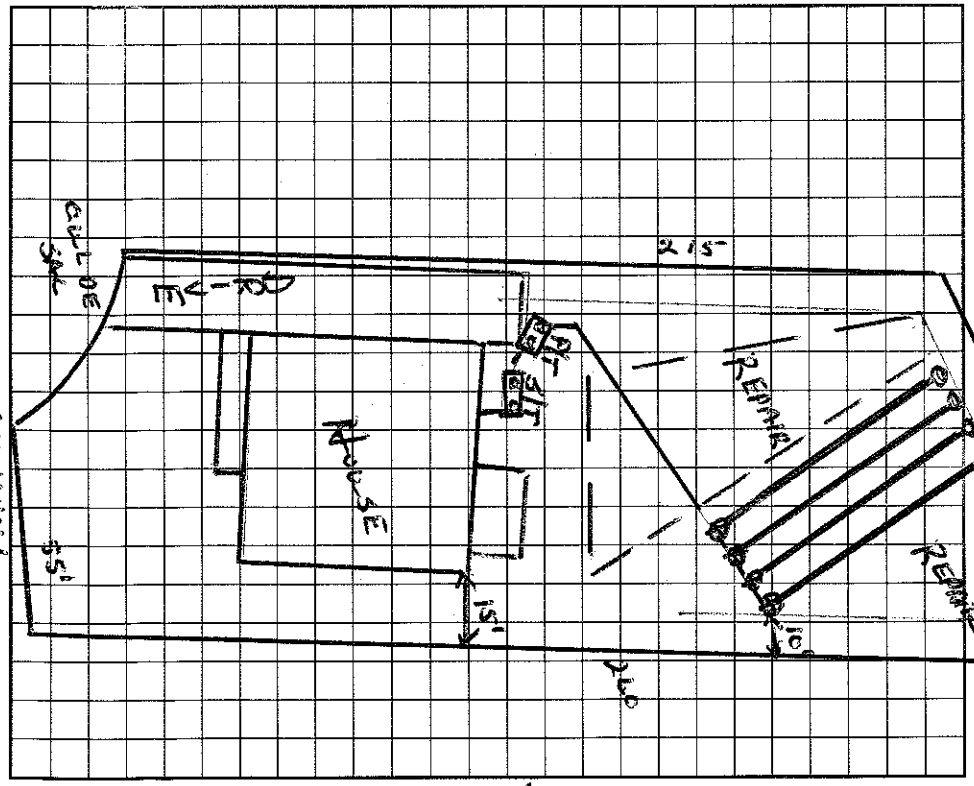

AS BUILT SKETCH

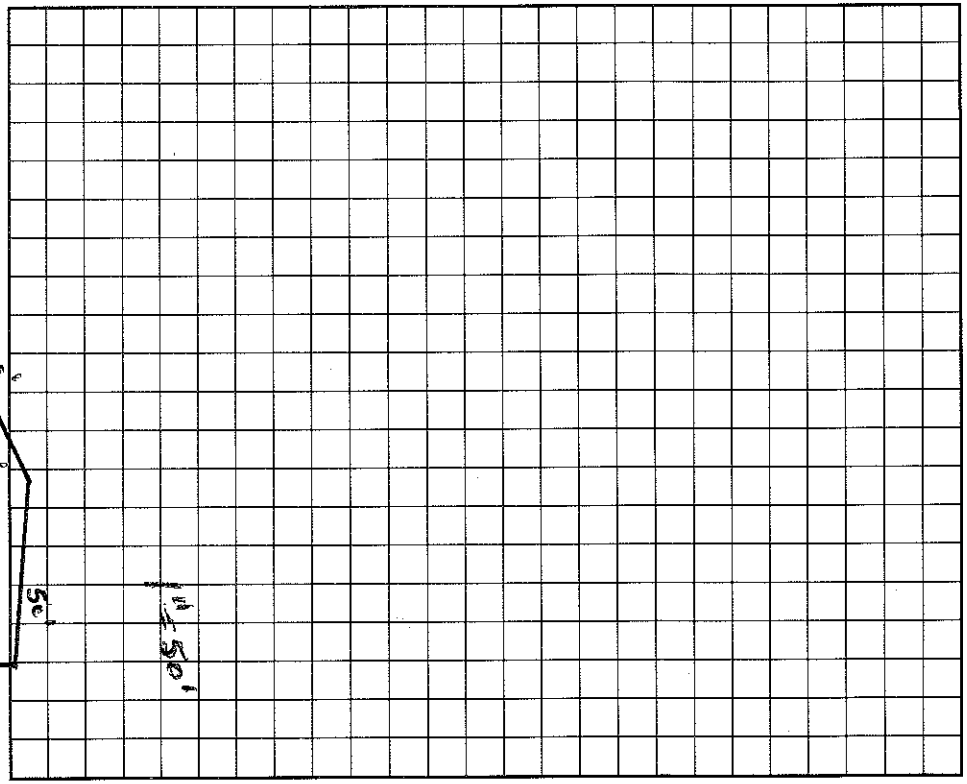

I understand that this permit can be suspended or revoked if any false information is supplied toward securing the permit/any unauthorized changes are made to the site/any unauthorized changes are made in the installation of the system. Improvement Permit is valid for 60 months from date of issuance.

Signed: * Wesley Sparks

Improvement Permit by: Wesley Sparks R.S. date 3/3/97

Existing System Inspection by: Wesley Sparks R.S. date 3/3/97

Installed by: MacLeod

Certificate of Completion by: Wesley Sparks R.S. date 8/29/97

Operation Permit by: Wesley Sparks R.S. date 8/29/97

HEALTH DEPT. COPY: WHITE INSPECTION COPY (FINAL): GREEN OWNER COPY (FINAL): YELLOW INSPECTION COPY (INITIAL): PINK OWNER COPY (INITIAL): GOLD