IREDELL COUNTY HEALTH DEPARTMENT Const. Auth. STATESVILLE 704-878-5305 MOORESVILLE 704-664-5281

IMPROVEMENT PERMIT / ~~CERTIFICATE OF COMPLETION~~ / OPERATION PERMIT / EXISTING SYSTEM INSPECTION

PROPERTY DESCRIPTION NO. 23371 DATE June 10, '96 TAX MAP NO. part of 2CA3 4626 30 8148 Watershed: ☑ ~~Yes~~ ☐ No

OWNER OR CONTRACTOR Crescent Resources Inc (Barry Burbank) PHONE: Business _____ Home _____

ADDRESS PO Box 1003 Charlotte

LOCATION Brawley Sch Rd TR Chickewood TL Morrows Ridge Ln TR Lake Spring Loop TR Windy Knoll on left

SUBDIVISION The Harbour BLOCK / SECTION III LOT 43 LOT AREA 230,086 ft² SITE CLASS. PSpa, 1456 DESIGN FLOW 480 gpd L.T.A.R. .13

Septic Tank: 1000 Gallons; STB 794 Date 3/7/97

Pump Tank: 1000 Gallons; PT 27 Date 3/8/97

Pump Make: HYDROMATIC Model SK50M Serial No. 516547-207

Nitrification Field: No Fields 1 Square Feet 1200 Linear Feet 400

No Lines 4 Trench Width 36" Max Trench Bottom Depth 36" Gravel Depth N/A

☑ New System ☐ Repair System Type: I, II, (III), IV, V, VI

System Description: pump&l-pn-chambered

Repair System Description: LP panel block

Maintenance Agreement Required: ☐ Yes ☑ ~~No~~

☑ ~~House/Mod. Home~~ ☐ Mobile Home ☐ Business ☐ Other

No. Bedrooms 4 No. Bathrooms 4 No. Employees ____

☐ Slab ☑ Crawl Space ☐ Basement w/plumbing ☐ Basement wo/plumbing


Water Supply: ☐ Individual ☐ Community ☑ ~~Public~~

Comments:


Comments:

INITIAL SITE SKETCH

1" = 50'

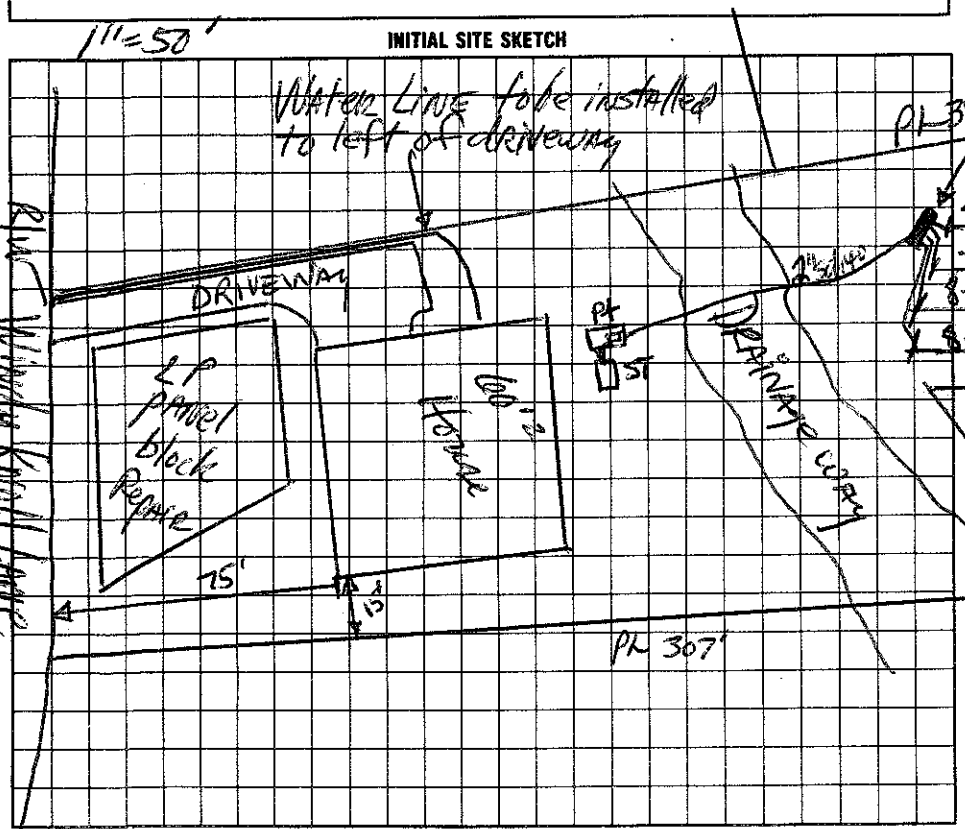

AS BUILT SKETCH

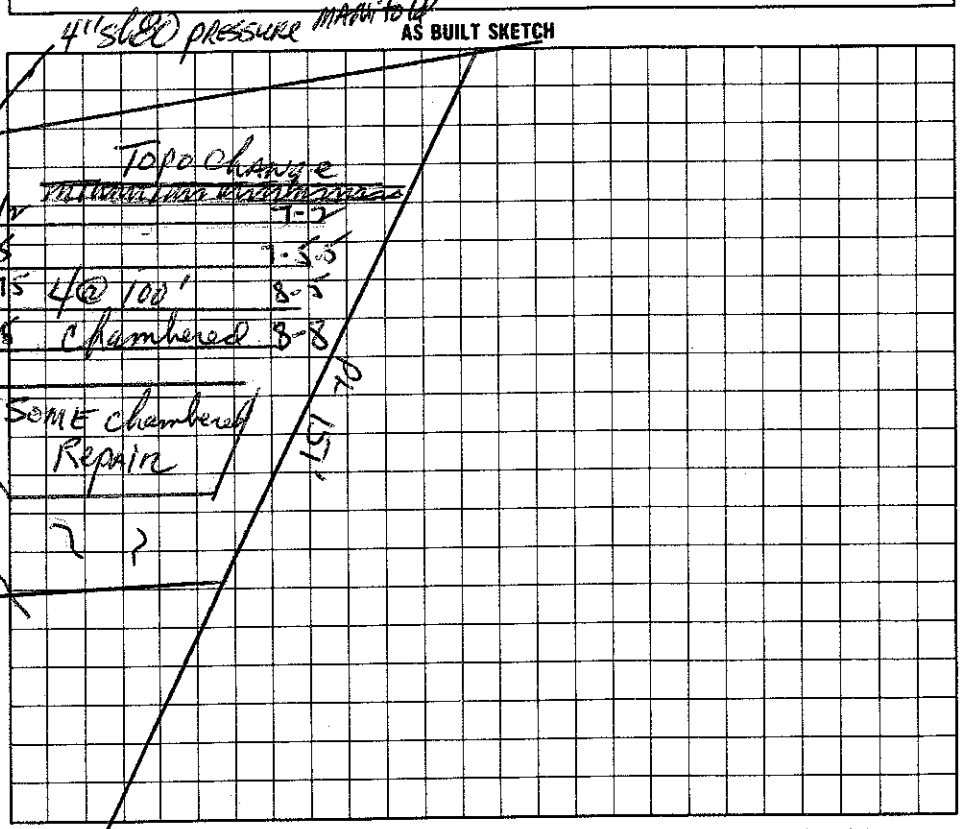

I understand that this permit can be suspended or revoked if any false information is supplied toward securing the permit/any unauthorized changes are made to the site/any unauthorized changes are made in the installation of the system.

Signed: X

Improvement Permit by: _____ date June 10, '96

~~Existing System Inspection by~~ Construction Authorization: _____ date 1/14/97

Installed by: Nickel Const.

Certificate of Completion by: _____ date _____

Operation Permit by: _____ date 7/24/97

HEALTH DEPT. COPY: WHITE INSPECTION COPY (FINAL): GREEN OWNER COPY (FINAL): YELLOW INSPECTION COPY (INITIAL): PINK OWNER COPY (INITIAL): GOLD