IREDELL COUNTY HEALTH DEPARTMENT

Authorization to Construct

STATESVILLE 704-878-5305 MOORESVILLE 704-664-5281

IMPROVEMENT PERMIT / ~~CERTIFICATE OF COMPLETION~~ / OPERATION PERMIT / EXISTING SYSTEM INSPECTION

PROPERTY DESCRIPTION NO. 068765 DATE 8/18/97 TAX MAP NO. 4626086074626308607 Watershed: X Yes ☐ No

OWNER OR CONTRACTOR Jimmy Benbenek PHONE: Business 365-9916 Home

ADDRESS 6525 Morison Blvd Charlotte, NC. 28211

LOCATION Bluff Sch. TR Chuckwood TR Morrows Ridge TR Lake Spring TR Windy Knoll Ln., 4th on (R)

SUBDIVISION Harbour BLOCK / SECTION III LOT 31 LOT AREA .59 SITE CLASS PS DESIGN FLOW 480 L.T.A.R. .3

Septic Tank: 1000 Gallons; STB 794 Date 12/9/97

Pump Tank: 1000 Gallons; PT 27 Date 12/9/97

Pump Make: HYDROMATIC Model SKF 50 A1 Serial No. 12/97

Nitrification Field: No Fields 1 Square Feet 1200 Linear Feet 400

No Lines 6 Trench Width 36" Max Trench Bottom Depth 36" Gravel Depth SAND

X New System ☐ Repair System Type: I, II, (III), IV, V, VI

System Description: Ch Plastic - Pres Man.

Repair System Description: Same

Maintenance Agreement Required: ☐ Yes ☐ No

X House/Mod. Home No. Bedrooms 4

☐ Mobile Home No. Bathrooms 3

☐ Business No. Employees

☐ Other


☐ Slab X Crawl Space ☐ Basement w/plumbing ☐ Basement wo/plumbing

Water Supply:
☐ Individual
X Community
☐ Public


Comments:

Comments: 3/26/98 - Riser damaged need 1/2" Plug in manifold and 24" stand pipe - ALS.

INITIAL SITE SKETCH

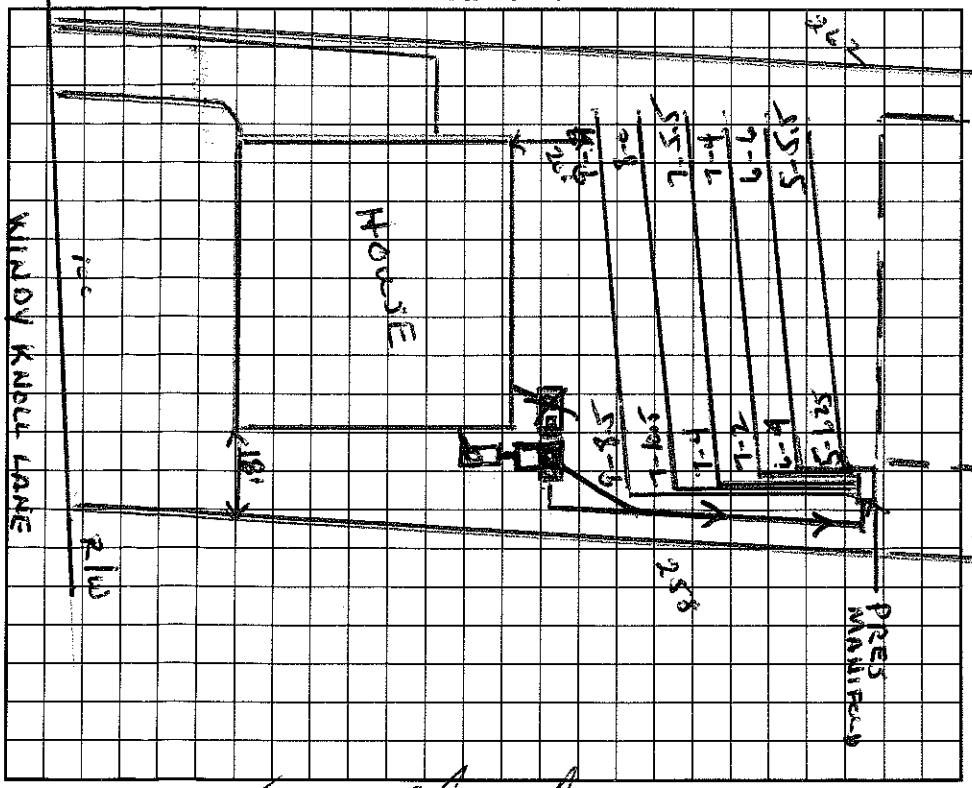

AS BUILT SKETCH

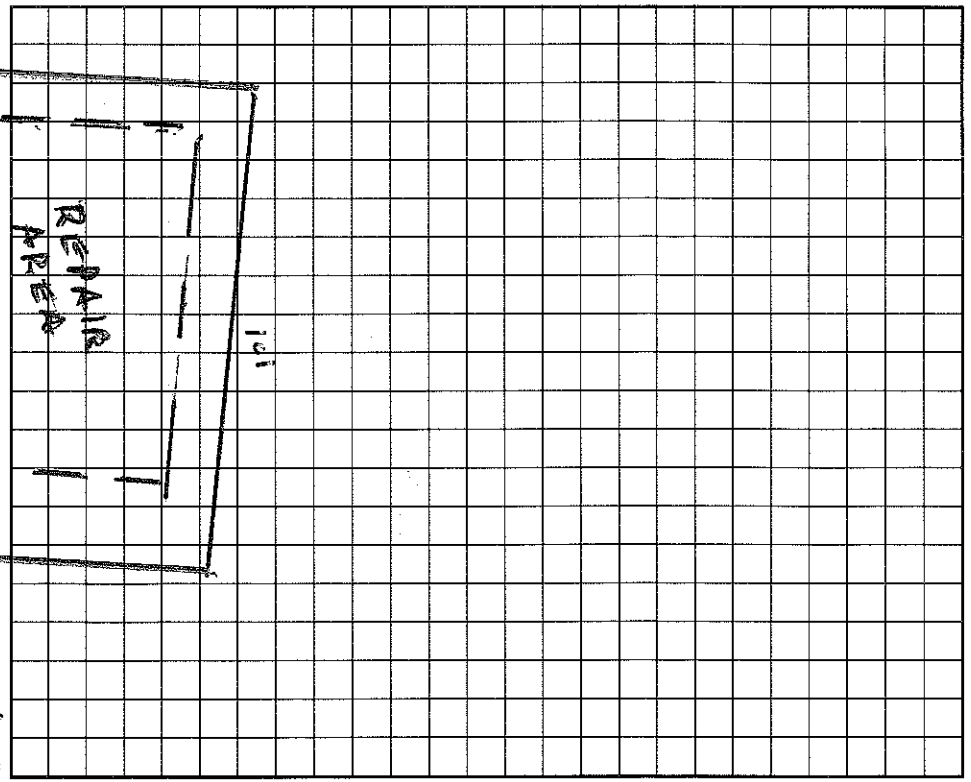

I understand that this permit can be suspended or revoked if any false information is supplied toward securing the permit/any unauthorized changes are made to the site/any unauthorized changes are made in the installation of the system. Improvement Permit is valid for 60 months from date of issuance.

Signed: X

Improvement Permit by: Wesley Sparks RS date 8/18/97

Existing System Inspection by: Wesley Sparks RS. date 8/18/97

Installed by: Macneal Const. Co

Certificate of Completion by: Wesley Sparks RS. date 3/27/98

Operation Permit by: Wesley Sparks RS date 3/27/98

HEALTH DEPT. COPY: WHITE INSPECTION COPY (FINAL): GREEN OWNER COPY (FINAL): YELLOW INSPECTION COPY (INITIAL): PINK OWNER COPY (INITIAL): GOLD