IREDELL COUNTY HEALTH DEPARTMENT

Authorization to Construct

STATESVILLE 704-878-5305 MOORESVILLE 704-664-5281

IMPROVEMENT PERMIT / ~~CERTIFICATE OF COMPLETION~~ / OPERATION PERMIT / EXISTING SYSTEM INSPECTION

PROPERTY DESCRIPTION NO. 067169 DATE 6/5/97 TAX MAP NO. 4626309042 Watershed: [X] Yes [ ] No

OWNER OR CONTRACTOR SAUSSY BURBANK PHONE: Business 662-3545 Home

ADDRESS 6525 Morrison Blvd Charlotte, NC. 28211

LOCATION Lake Spring Loop. - Bay Harbour TR Lake Spring Loop, on (R) at 2nd intersection of Lake Sp. and B. HAR.

SUBDIVISION HARBOUR BLOCK / SECTION III LOT 45 LOT AREA .63 SITE CLASS. PS DESIGN FLOW 480 L.T.A.R. .3

Septic Tank: 1000 Gallons; STB 794 Date 8-7-97
Pump Tank: 1000 Gallons; PT 727 Date 9-4-97
Pump Make: Model Serial No.
Nitrification Field: No Fields 1 Square Feet 1200 Linear Feet 400 ✱
No Lines 4 Trench Width 36" Max Trench Bottom Depth 36" Gravel Depth STNE

[X] New System [ ] Repair System Type: I, II, [III] IV, V, VI
System Description: ~~Pres~~ → CH. PLASTIC
Repair System Description: Pres → 16" PPBS
Maintenance Agreement Required: [X] Yes [ ]

[X] House/Mod. Home No. Bedrooms 4
[ ] Mobile Home No. Bathrooms 3
[ ] Business No. Employees
[ ] Other


[ ] Slab [X] Crawl Space [ ] Basement w/plumbing [ ] Basement wo/plumbing

Water Supply: [ ] Individual [X] Community [ ] Public


Comments: ✱ Chem. Plastic off 4" SCH 80 Pres Man. in protective box - insp. port required. Sand fill around louvers required

Comments: Changed Drainfield to 5 at 80' Trenches 42" Tanks & lines checked 10/16/97 MS No Inspection ports installed yet.

INITIAL SITE SKETCH

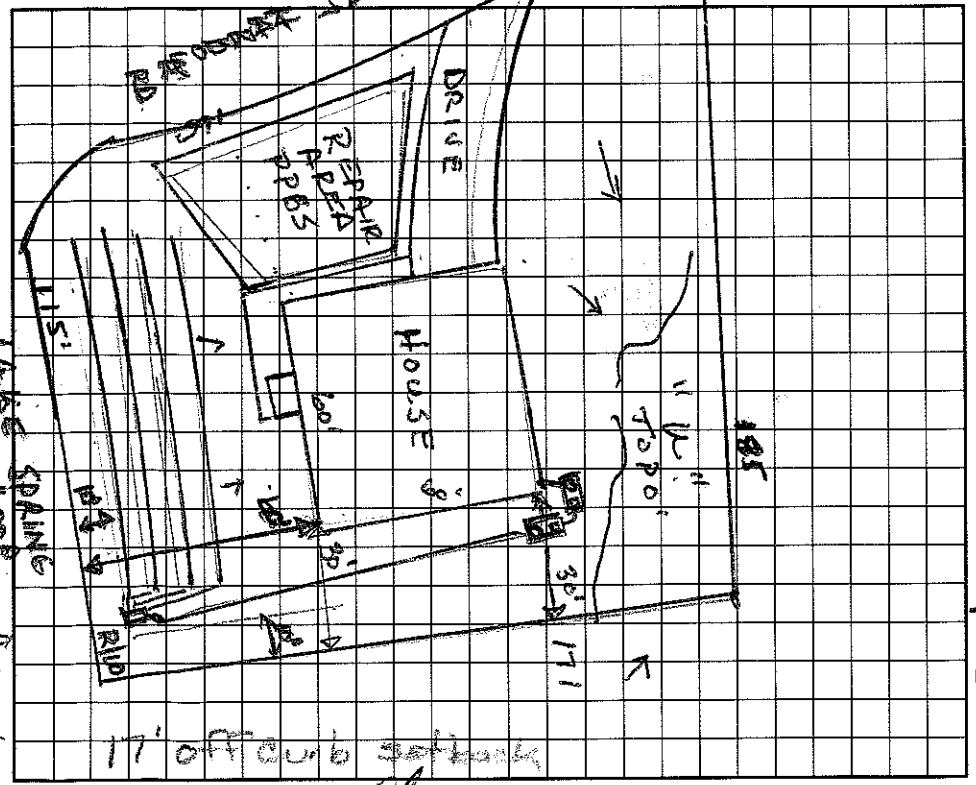

AS BUILT SKETCH Scale 1:50

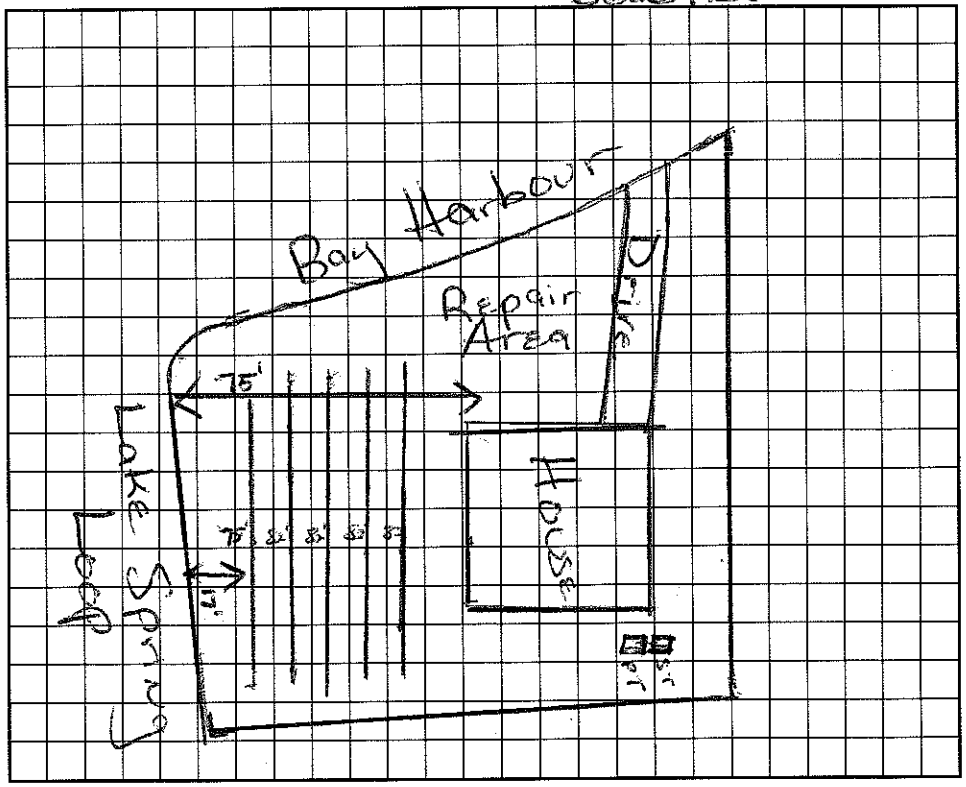

I understand that this permit can be suspended or revoked if any false information is supplied toward securing the permit/any unauthorized changes are made to the site/any unauthorized changes are made in the installation of the system. Improvement Permit is valid for 60 months from date of issuance.

Signed: ✱

Improvement Permit by: Wesley Sparks R.S. date 6/5/97

~~Existing System Inspection by:~~ Wesley Sparks R.S. date 6/5/97

Installed by: Machine & Const

Certificate of Completion by: Wesley Sparks R.S. date 11/19/97

Operation Permit by: Wesley Sparks R.S. date 11/19/97

HEALTH DEPT. COPY: WHITE / INSPECTION COPY (FINAL): GREEN / OWNER COPY (FINAL): YELLOW / INSPECTION COPY (INITIAL): PINK / OWNER COPY (INITIAL): GOLD