IREDELL COUNTY HEALTH DEPARTMENT / Authorization to Construct

STATESVILLE 704-878-5305 MOORESVILLE 704-664-5281

IMPROVEMENT PERMIT / ~~CERTIFICATE OF COMPLETION~~ / OPERATION PERMIT / EXISTING SYSTEM INSPECTION

PROPERTY DESCRIPTION NO. 25653 DATE 12/5/96 TAX MAP NO. 2EC5 Pt of Watershed: X Yes ☐ No

OWNER OR CONTRACTOR Jimmy Burbank PHONE: Business 365-9916 ~~Home~~ 462630-9291

ADDRESS 6525 Mourson Blvd. Charlotte, NC.

LOCATION (R) corner of Lake Spring Loop & Windy Knoll Ln. intersection

SUBDIVISION Harbour BLOCK / SECTION III LOT 44 LOT AREA .74Ac SITE CLASS. PS DESIGN FLOW 480 L.T.A.R. .3

Septic Tank: 1000 Gallons; STB 794 Date 3/22/97

Pump Tank: ____ Gallons; PT ____ Date ____

Pump Make: ____ Model ____ Serial No. ____

Nitrification Field: No Fields 1 Square Feet 1200 Linear Feet ~~X~~ 400

No Lines 4 Trench Width 36" Max Trench Bottom Depth 36" Gravel Depth SAND

X New System ☐ Repair System Type: I, II, (III) IV, V, VI

System Description: ~~X~~ CH PLASTIC

Repair System Description: ~~STENCH~~ 16" PPBS

Maintenance Agreement Required: ☐ Yes ☐ No

X House/Mod. Home No. Bedrooms 4

☐ Mobile Home No. Bathrooms 3.5

☐ Business No. Employees ____

☐ Other ____

☐ Slab X Crawl Space ☐ Basement w/plumbing ☐ Basement wo/plumbing


Water Supply: ☐ Individual X Community ☐ Public

Comments: Crawl Space must be high enough to use gravity to Septic Tank. Sch 40 PVC through 6" Conc. Steel Culvert under driveway.

1"=50'

Comments:

INITIAL SITE SKETCH

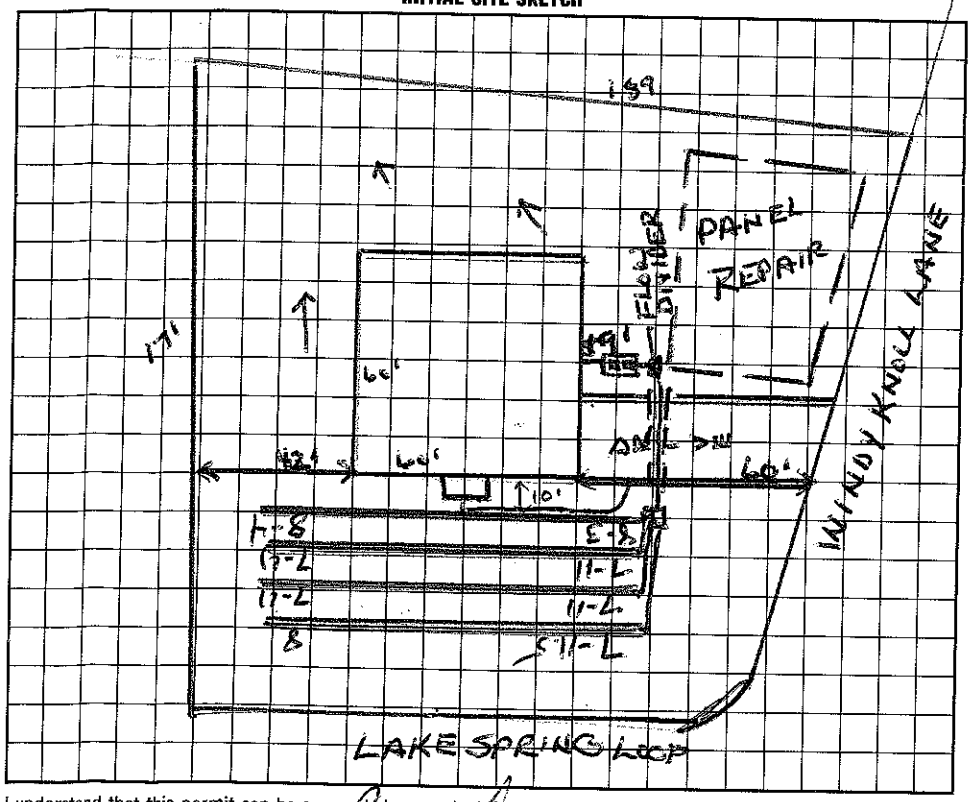

AS BUILT SKETCH

I understand that this permit can be suspended or revoked if any false information is supplied toward securing the permit/any unauthorized changes are made to the site/any unauthorized changes are made in the installation of the system.

Signed: ~~X~~

Improvement Permit by: Wesley Sparks RS date 12/5/96

~~Existing System Inspection~~ by: Wesley Sparks RS date 12/5/96

Installed by: Macleod

Certificate of Completion by: Wesley Sparks RS. date 6/24/97

Operation Permit by: Wesley Sparks RS. date 6/24/97

HEALTH DEPT. COPY: WHITE INSPECTION COPY (FINAL): GREEN OWNER COPY (FINAL): YELLOW INSPECTION COPY (INITIAL): PINK OWNER COPY (INITIAL): GOLD