Authorization to Construct

IREDELL COUNTY HEALTH DEPARTMENT

STATESVILLE 704-878-5305 MOORESVILLE 704-664-5281

IMPROVEMENT PERMIT / ~~CERTIFICATE OF COMPLETION~~ / OPERATION PERMIT / EXISTING SYSTEM INSPECTION

PROPERTY DESCRIPTION NO. 25780 DATE 1/21/97 TAX MAP NO. 4625941684 (pt) Watershed: ☒ Yes ☐ No

OWNER OR CONTRACTOR Sunny Burbank PHONE: Business 365-9916 Home 4626309439

ADDRESS 6525 Morrison Blvd. Charlotte, NC.

LOCATION Bay Harbour TR 2ND Lake Springs Ln. TL Windy Knoll Ln., 2ND lot on Ⓡ

SUBDIVISION Harbour BLOCK / SECTION 3 LOT 29 LOT AREA 1.72 Ac SITE CLASS. PS DESIGN FLOW 480 L.T.A.R. .3

Septic Tank: 1000 Gallons; STB 794 Date 2/11/97

Pump Tank: 1000 Gallons; PT 47 Date 7/18/97

Pump Make: ______ Model ______ Serial No. ______

Nitrification Field: No Fields 1 Square Feet 1200 * Linear Feet 400 *

No Lines 5 Trench Width 36" Max Trench Bottom Depth 36" Gravel Depth SAND.

☒ New System ☐ Repair System Type: I, II, (III), IV, V, VI

System Description: Pres Man - Ch. Plastic

Repair System Description: Same

Maintenance Agreement Required: ☐ Yes ☒ No

☒ House/Mod. Home ☐ Mobile Home ☐ Business ☐ Other

No. Bedrooms 4 No. Bathrooms 2.5 No. Employees ______


☐ Slab ☒ Crawl Space ☐ Basement w/plumbing ☐ Basement wo/plumbing

Water Supply: ☐ Individual ☒ Community ☐ Public


Comments:

Comments: NEMA4X Box Checked 10/14/97 & Alarm

INITIAL SITE SKETCH

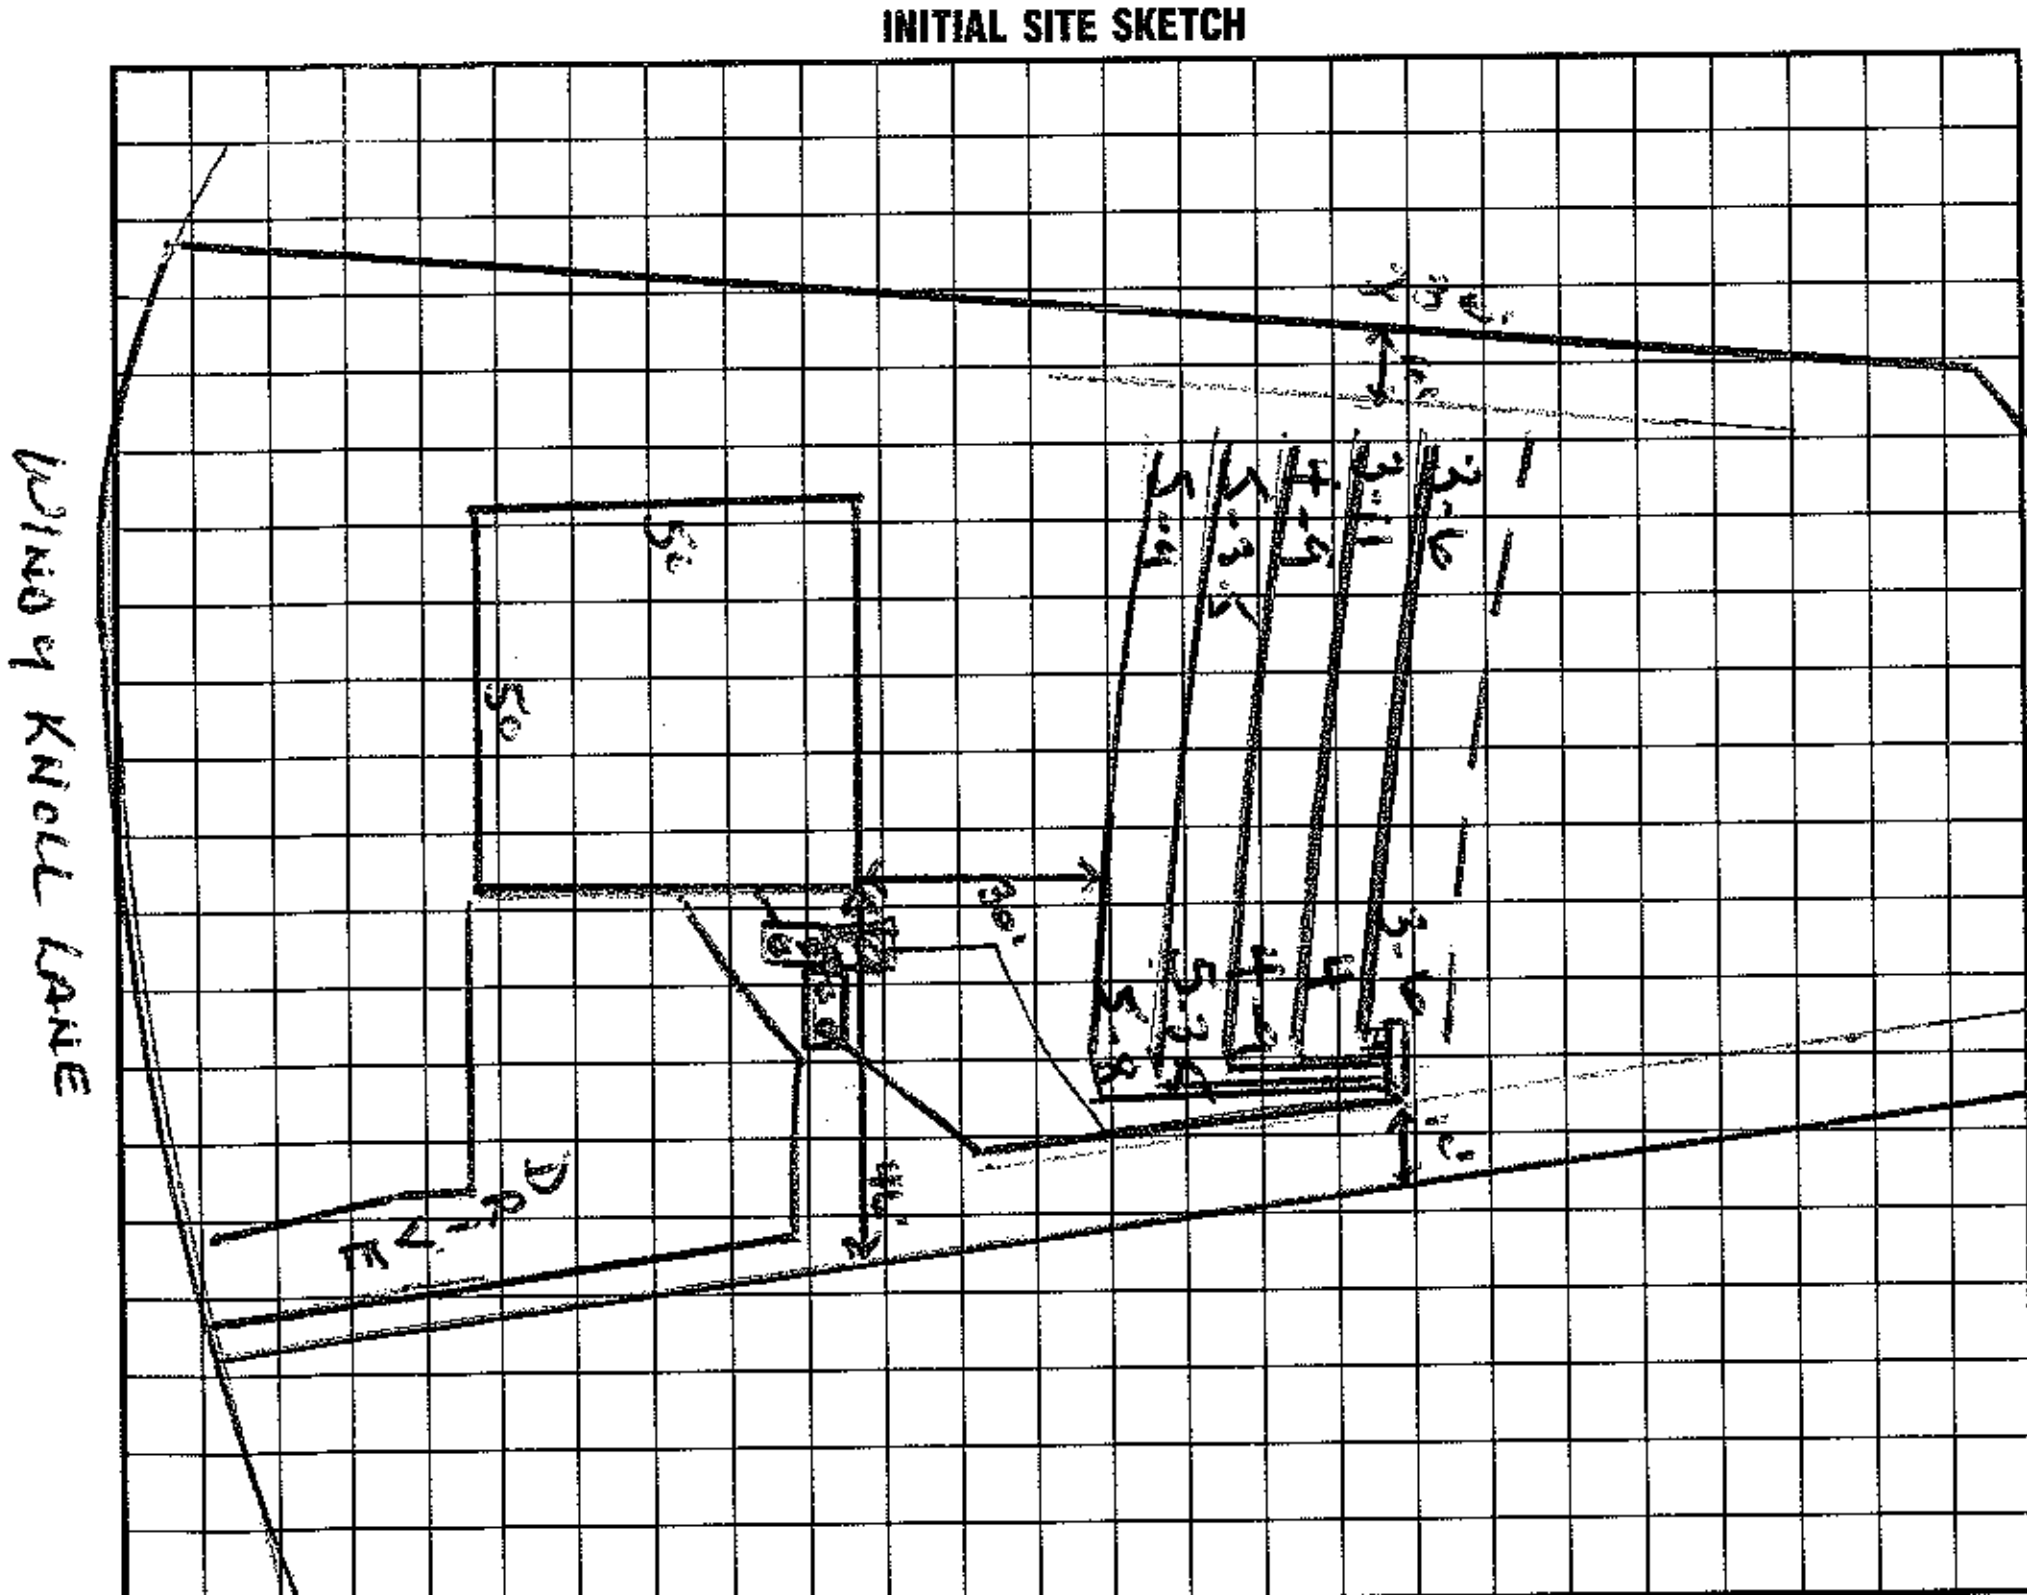

AS BUILT SKETCH

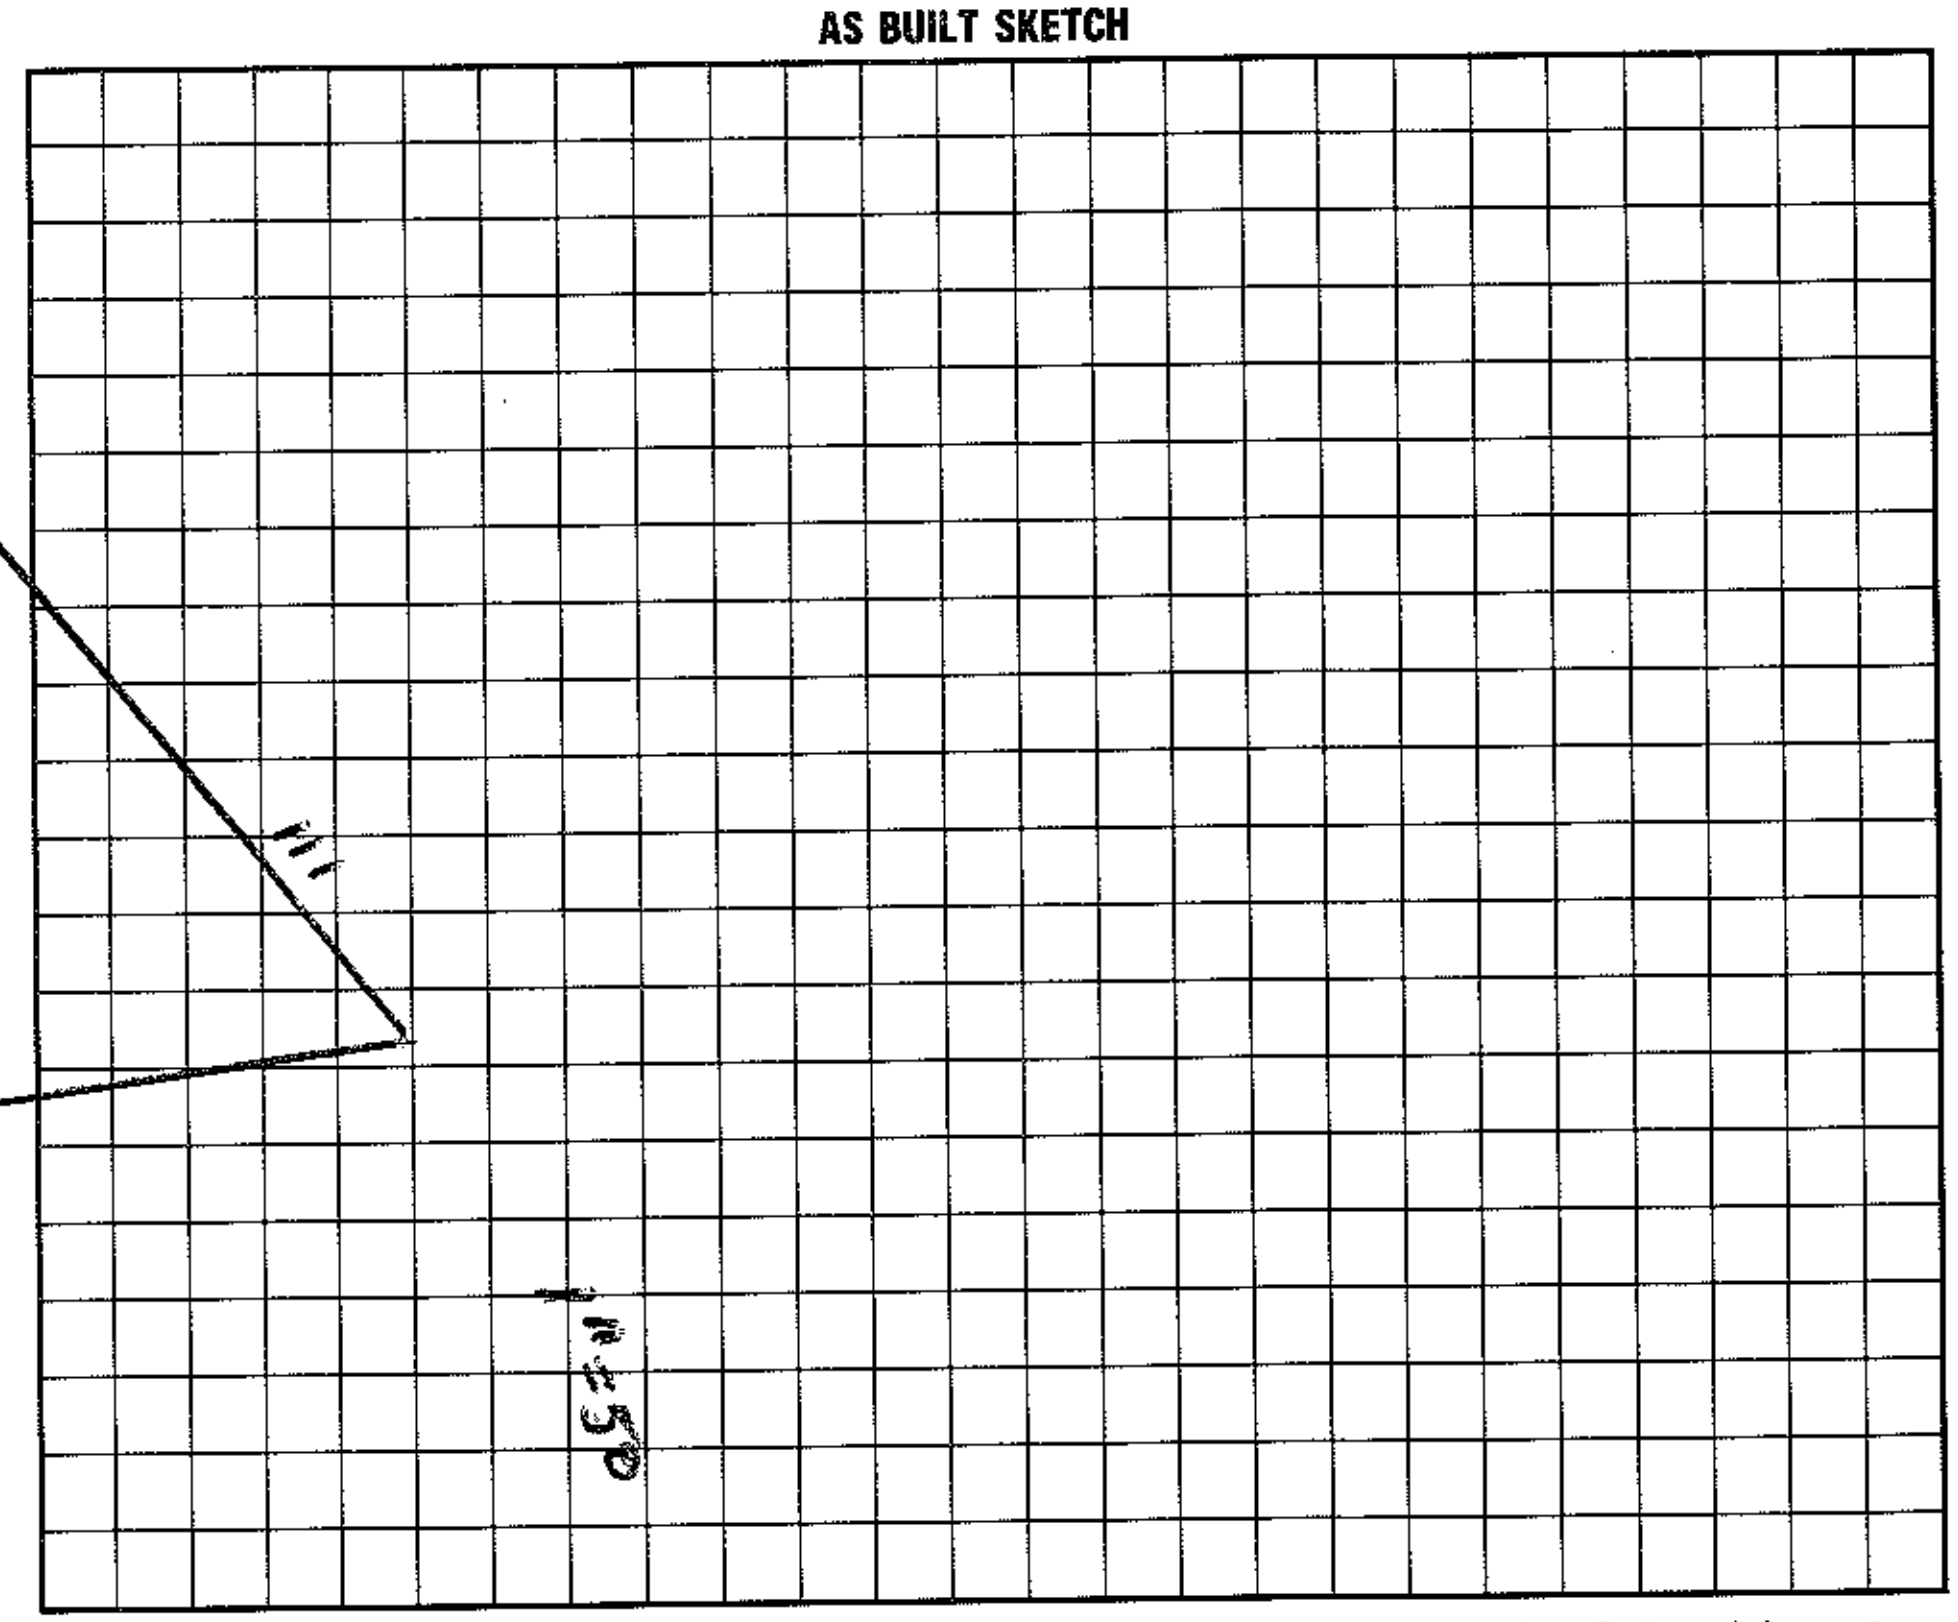

I understand that this permit can be suspended or revoked if any false information is supplied toward securing the permit/any unauthorized changes are made to the site/any unauthorized changes are made in the installation of the system. Improvement Permit is valid for 60 months from date of issuance.

Signed: [signature]

Improvement Permit by: Wesley Sparks R.S. date 1/21/97

Existing System Inspection by: Wesley Sparks R.S. date 1/21/97 (Auth. to Const.)

Installed by: MacLeod

Certificate of Completion by: Maria H. Dotson date 10/14/97

Operation Permit by: Maria H. Dotson date 10/14/97

HEALTH DEPT. COPY: WHITE INSPECTION COPY (FINAL): GREEN OWNER COPY (FINAL): YELLOW INSPECTION COPY (INITIAL): PINK OWNER COPY (INITIAL): GOLD