Authorization to Construct

IREDELL COUNTY HEALTH DEPARTMENT

STATESVILLE 704-878-5305 MOORESVILLE 704-664-5281

IMPROVEMENT PERMIT / ~~CERTIFICATE OF COMPLETION~~ / OPERATION PERMIT / EXISTING SYSTEM INSPECTION

PROPERTY DESCRIPTION NO. 25510 DATE 11/16/97 TAX MAP NO. 2CA3 pt of. 4626309779 Watershed: [X] Yes [ ] No

OWNER OR CONTRACTOR Sauney Bayhawk PHONE: Business 365-9916 Home

ADDRESS 6525 Morrison Blvd. Charlotte, NC.

LOCATION Wildbriar In. - 1100 TR Bay Harbour TR Lake Spring TR Monroes Ridge Tl Wildbriar to old sea on (R)

SUBDIVISION HARBOUR BLOCK / SECTION 3 LOT 18 LOT AREA .66 Ac SITE CLASS. PS DESIGN FLOW 480 L.T.A.R. .3

Septic Tank: 1000 Gallons; STB 794 Date 7/16/97

Pump Tank: 1000 Gallons; PT 27 Date 6/11/97

Pump Make: Model Serial No.

Nitrification Field: No Fields 1 Square Feet 1200 Linear Feet * 400

No Lines 4 Trench Width 36" Max Trench Bottom Depth 36" Gravel Depth SAND

[X] New System [ ] Repair System Type: I, II, (III) IV, V, VI

System Description: * PRESMAN - CA PLASTIC

Repair System Description: SAME

Maintenance Agreement Required: [ ] Yes [ ] No

[X] House/Mod. Home No. Bedrooms 4

[ ] Mobile Home No. Bathrooms 2.5

[ ] Business No. Employees

[ ] Other


[ ] Slab [X] Crawl Space [ ] Basement w/plumbing [ ] Basement wo/plumbing

Water Supply: [ ] Individual [X] Community [ ] Public

Comments:

Comments: TRENCHES LEFT OPEN DURING HEAVY RAINS - SYSTEM WAS SATURATED. ADVISED TO PUMP OUT TRENCHES W/ PUMP & LOWEST LINE TRENCH THAT WAS CUT TO BE PACKED. LINES, TANKS Checked 7/29/97 C. [illegible]

INITIAL SITE SKETCH

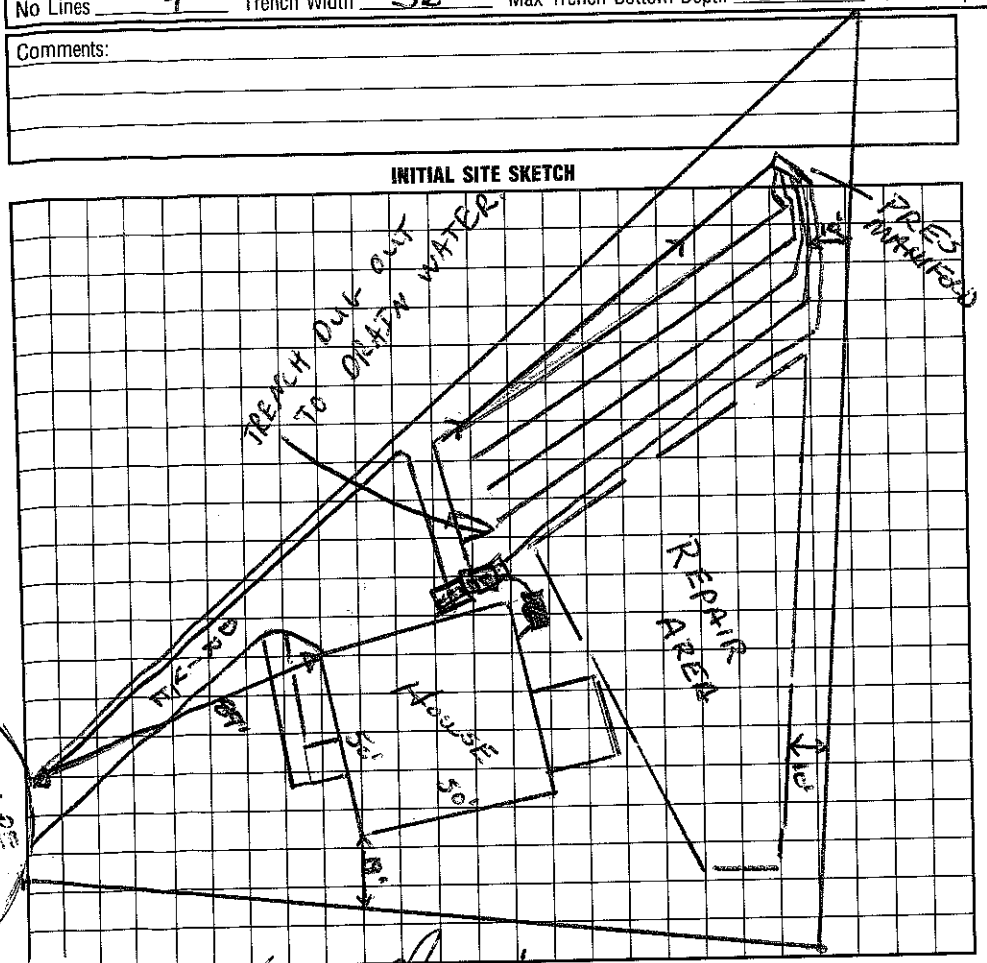

AS BUILT SKETCH

7/31/97 Set sequence pressure - Electrical and alarm testing -

and that this permit can be suspended or revoked if any false information is supplied toward securing the permit/any unauthorized changes are made to the site/any unauthorized changes are made in the installation of the system. Permit is valid for 60 months from date of issuance.

Installed by: Macleod Construction

Certificate of Completion by: Wesley Sparks R.S. date 9/24/97

Operation Permit by: Wesley Sparks R.S. date 9/24/97

Wesley Sparks R.S. date 1/17/97

Wesley Sparks R.S. date 1/17/97

INSPECTION COPY (FINAL): GREEN OWNER COPY (FINAL): YELLOW INSPECTION COPY (INITIAL): PINK OWNER COPY (INITIAL): GOLD