Amenities Area 3:00

IREDELL COUNTY HEALTH DEPARTMENT

STATESVILLE 704-878-5305 MOORESVILLE 704-664-5281

IMPROVEMENT PERMIT / AUTHORIZATION TO CONSTRUCT / OPERATION PERMIT / EXISTING SYSTEM INSPECTION

PERMIT# 148043 PIN# 4626 31 ~~3433~~ 1400 DATE 4/7/08

OWNER OR APPLICANT MID ATLANTIC CONST PHONE: Business 704-702-5568 Home

ADDRESS PO BOX 3792 MOORESVILLE, NC. 28115

LOCATION 1100 TR C HILLKINOOD TL 1ST BARBER LP., LOT ON IMMEDIATE (R)

SUBDIVISION WATERTREE LANDING SECTION LOT 104 LOT AREA ~.53AC SITE CLASS. PS DESIGN FLOW 365GPD L.T.A.R. .3

Septic Tank: 1000 Gallons: STB 825 Date 4-24-08

Pump Tank: Gallons: PT Date

Pump Make: Model Serial No.

Nitrification Field: No Fields 1 Square Feet 912 Linear Feet 304

No Lines 3 Trench Width 3' Max Trench Bottom Depth 3' Gravel Depth No

☒ New System ☐ Repair ☐ Expansion System Type: I II III IV V VI

System Description: GRAVITY - 25% REDUCTION

Repair System Description: LP - 16" PABPS

Maintenance Agreement Required: ☐ Yes ☒ No

☒ Gravity ☐ Pressure ☒ Slab ☐ Crawl Space ☐ Basement w/plumbing ☐ Basement wo/plumbing

☐ House/Mod. Home No. Bedrooms

☐ Mobile Home No. Persons

☐ Business No. Employees


☒ Other 73 LOTS @ 5GAL/LOT

Water Supply: ☒ Individual ☐ Public ☐ Community TNC

Comments:/Conditions:


1" = 40'

INITIAL SITE SKETCH

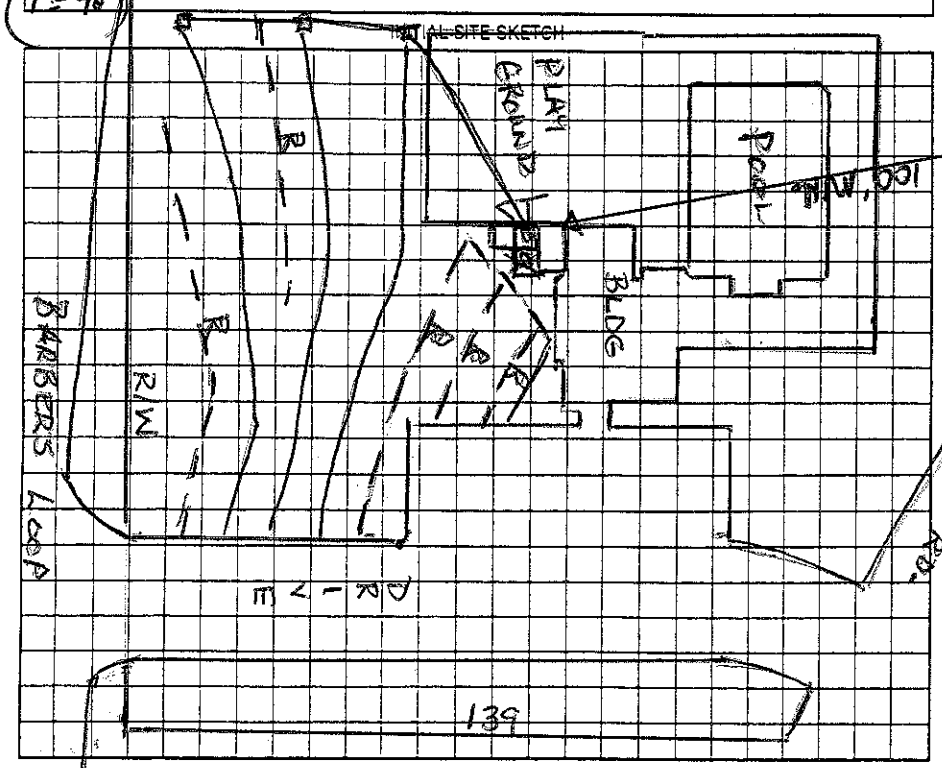

Comments:/Conditions: 3 lines @ 110 FT = Drainfield Used Quick 4 Feed thru endcaps. ST ~ 5FT of Corner of buildings

AS BUILT SKETCH

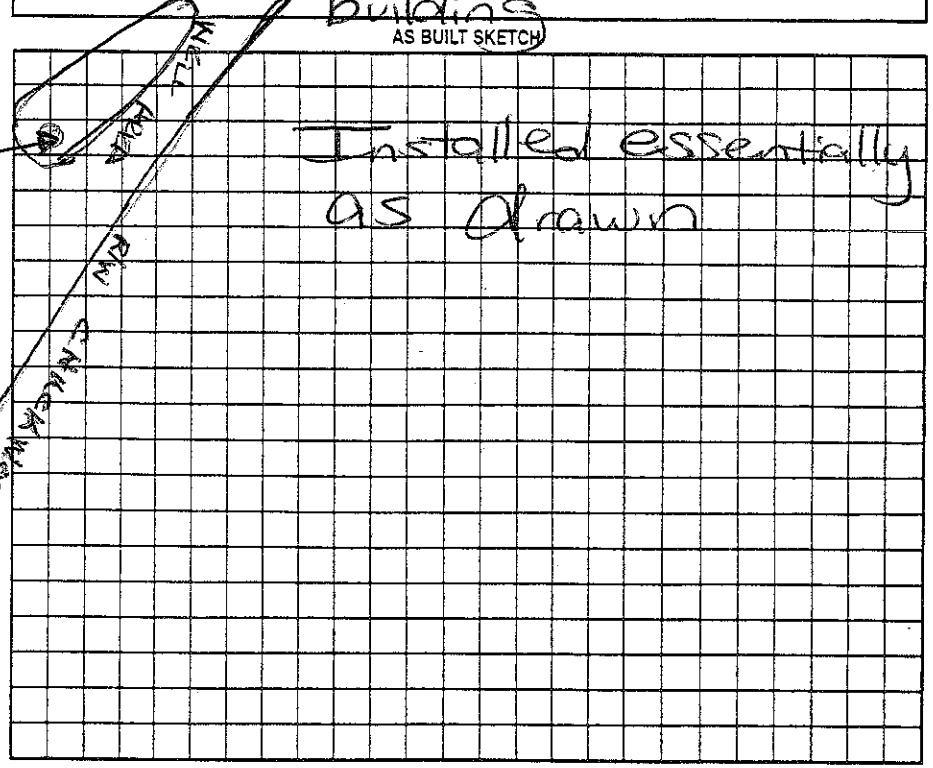

Permit can be suspended or revoked if any false information is supplied toward securing the permit/any unauthorized changes are made to the site/any unauthorized changes are made in the installation of the system. Improvement Permit/with plat valid without expiration ☐ Improvement Permit with site plan valid for sixty months ☐ Authorization to Construct is valid for a period equal to that of Improvement Permit – not to exceed sixty months.

Signed: [signature] date 4/17/08

Improvement Permit by: Wesley Sparks RS. date 4/7/08

Authorization to Construct by: Wesley Sparks RS date 4/7/08

Installed by: Rollins Environmental

Operation Permit by: Maria Brooks RS date 7/1/09

Existing System Inspection by: date

HEALTH DEPT. COPY: WHITE OWNER COPY (FINAL): YELLOW OWNER COPY (INITIAL): PINK