IREDELL COUNTY HEALTH DEPARTMENT

STATESVILLE 704-878-5305 MOORESVILLE 704-664-5281

IMPROVEMENT PERMIT / CERTIFICATE OF COMPLETION / OPERATION PERMIT / EXISTING SYSTEM INSPECTIO

PROPERTY DESCRIPTION NO. 19424 DATE Oct-4-94 TAX MAP NO. 2F6A98 Watershed: ☐ Yes ☐ N

OWNER OR CONTRACTOR Loy Allen Earp PHONE Business 462-31-1847 Home 910-667-1996 LN

ADDRESS 134 Ralph Dingwood Dr, N. Wilkesboro 28659

LOCATION 1100 TR 1177 TR Riviera TL 1st St. on END ON left

SUBDIVISION Holiday Harbor BLOCK / SECTION ____ LOT 98 LOT AREA 130 X 170' SITE CLASS. RS DESIGN FLOW 360gpd L.T.A.R. .3

Septic Tank: 1000 Gallons; STB BCC 854 Date 9-6-94

Pump Tank: ____ Gallons; PT ____ Date ____

Pump Make: ____ Model ____ Serial No. ____

Nitrification Field: No Fields 2 Square Feet 1200 Linear Feet 400

No Lines 3+3 Trench Width 36" Max Trench Bottom Depth 36" Gravel Depth 12"

☑ New System ☐ Repair System Type: I, II, III, IV, V, VI

System Description: gravity conventional

Repair System Description: same

Maintenance Agreement Required: ☐ Yes ☑ No

☐ House/Mod. Home No. Bedrooms 3

☐ Mobile Home No. Bathrooms 2

☐ Business No. Employees ____

☐ Other ____


☐ Slab ☑ Crawl Space ☐ Basement w/plumbing ☐ Basement wo/plumbing

Water Supply: ☑ Individual ☐ Community ☐ Public


Comments: follow contour w/ laterals

Comments: Well not installed as of 11/4/94

INITIAL SITE SKETCH

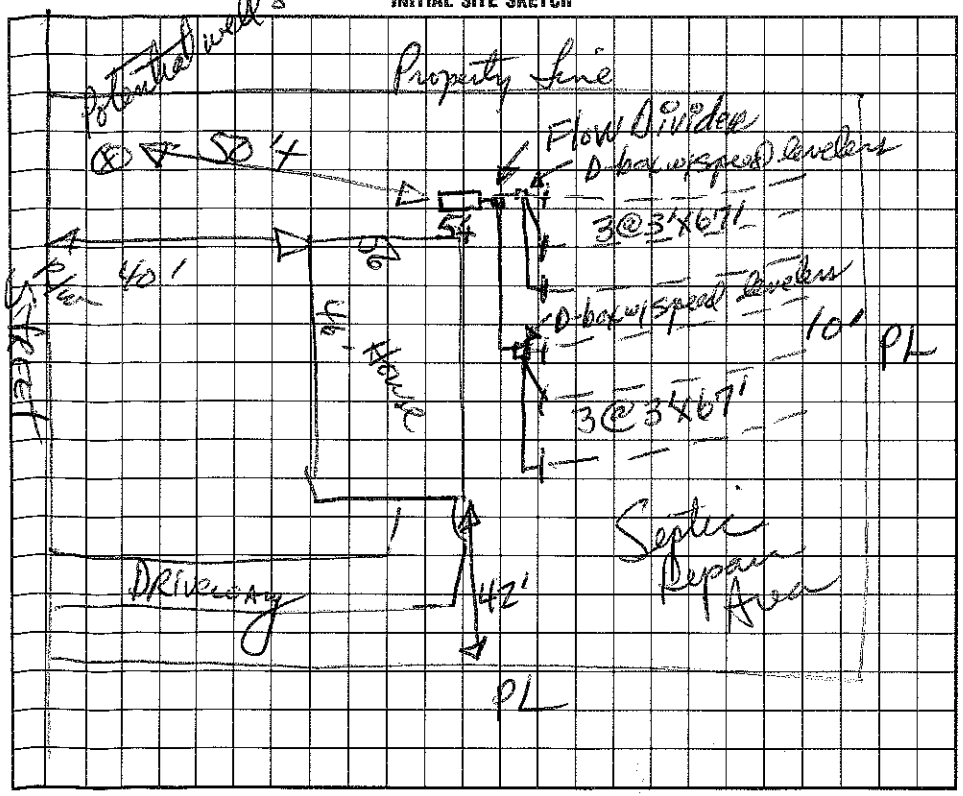

AS BUILT SKETCH

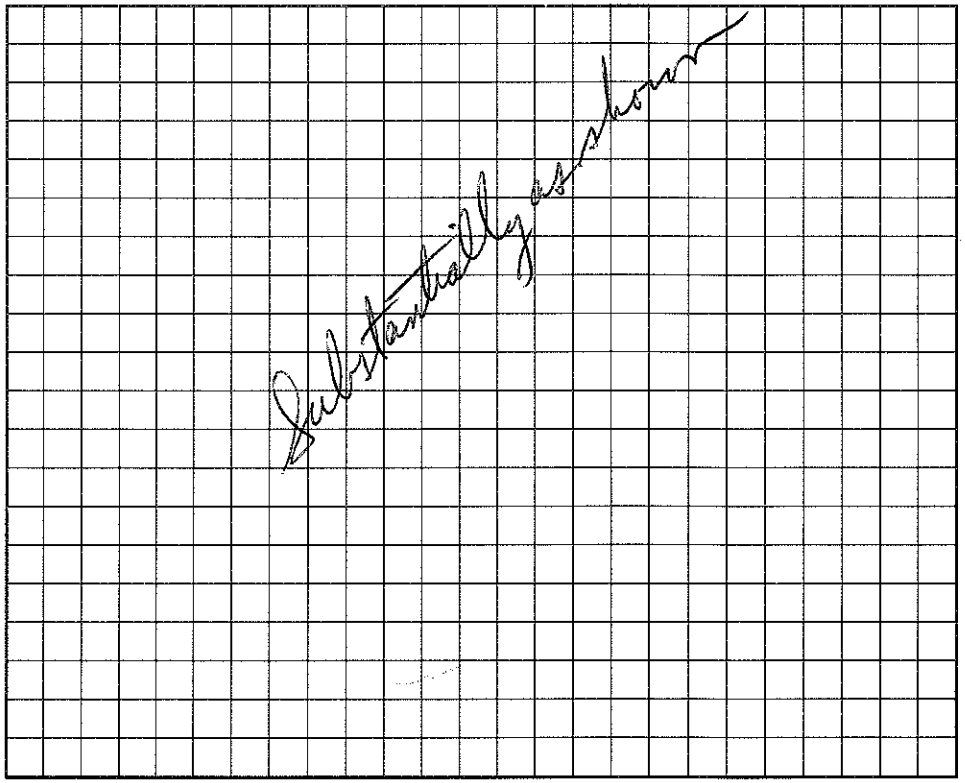

I understand that this permit can be suspended or revoked if any false information is supplied toward securing the permit/any unauthorized changes are made to the site/any unauthorized changes are made in the installation of the system. Improvement Permit is valid for 60 months from date of issuance.

Signed: Ralph Dingwood by Jerry Allen Earp

Improvement Permit by: Harold D. Hinson, RS date 10/4/94

Existing System Inspection by: ____ date ____

Installed by: Blackburn & Sons, Wilkes Co.

Certificate of Completion by: D.R. Hinson RS date 11/4/94

Operation Permit by: ____ date ____

HEALTH DEPT. COPY: WHITE INSPECTION COPY (FINAL): GREEN OWNER COPY (FINAL): YELLOW INSPECTION COPY (INITIAL): PINK OWNER COPY (INITIAL): GOLD