IREDELL COUNTY HEALTH DEPARTMENT

STATESVILLE 704-878-5305 MOORESVILLE 704-664-5281

IMPROVEMENT PERMIT / AUTHORIZATION TO CONSTRUCT / OPERATION PERMIT / EXISTING SYSTEM INSPECTION

PERMIT# 088900 PIN# 4626 31 5824 DATE 4/28/00

OWNER OR CONTRACTOR Easyway Inc. PHONE: Business Home 664-7727

ADDRESS PO Box 3303 Mooresville, NC 28117

LOCATION 1100 TR Chuckwood TR Seagrove TL Pine Bluff, 5th on (L)

SUBDIVISION Holiday Harbor BLOCK / SECTION LOT 101 LOT AREA .46AC SITE CLASS. AS DESIGN FLOW 360 L.T.A.R. .3

Septic Tank: 1000 Gallons; STB 1012 Date 2/6/00

Pump Tank: Gallons; PT Date

Pump Make: Model Serial No.

Nitrification Field: No Fields 1 Square Feet 900 * Linear Feet 300 *

No Lines 3 @ 100'x3' Trench Width 36" Max Trench Bottom Depth 36"

[X] New System [ ] Repair System Type: I, II, (III) IV, V, VI

System Description: GRAVITY - CH PLAS OR HDS

Repair System Description: SAME

Maintenance Agreement Required: [ ] Yes [X] No

~~Gravel Depth~~ SAND

[X] House/Mod. Home No. Bedrooms 3

[ ] Mobile Home No. Bathrooms 2

[ ] Business No. Employees


[ ] Other

[ ] Slab [X] Crawl Space [ ] Basement w/plumbing [ ] Basement wo/plumbing

Water Supply: [X] Individual [ ] Public [ ] Community

Comments:/Conditions:

INITIAL SITE SKETCH

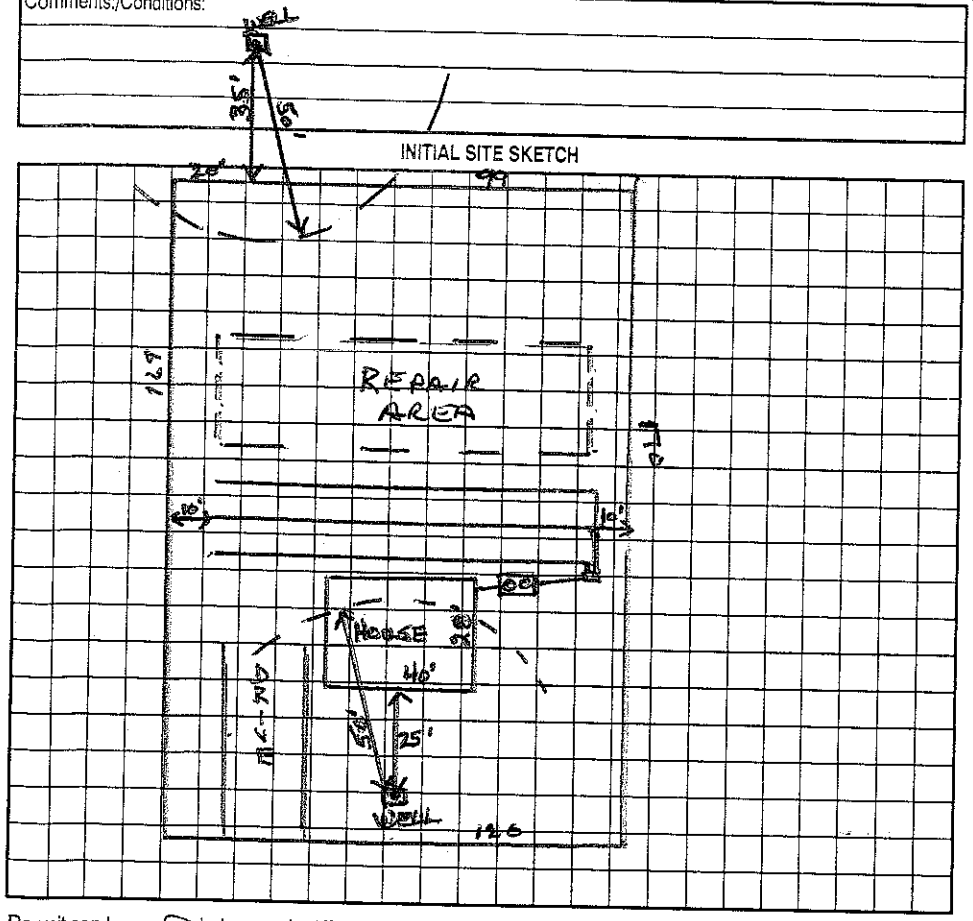

Comments:/Conditions: Installed filter & riser
Installed as drawn
Installed Plastic Chambers

AS BUILT SKETCH

Permit can be suspended or revoked if any false information is supplied toward securing the permit/any unauthorized changes are made to the site/any unauthorized changes are made in the installation of the system. Improvement Permit with plat valid without expiration. Improvement Permit with site plan valid for sixty months. Authorization to Construct is valid for a period equal to that of Improvement Permit – not to exceed sixty months.

Signed: X date

Improvement Permit by: Wesley Sparks RS. date 4/28/00

Authorization to Construct by: Wesley Sparks RS. date 4/28/00

Installed by: Richard Abernathy date 6/8/2000

Operation Permit by: Marvin H. Dotson RS date 6/8/2000

Existing System Inspection by: date

HEALTH DEPT. COPY: WHITE OWNER COPY (FINAL): YELLOW OWNER COPY (INITIAL): PINK