IREDELL COUNTY HEALTH DEPARTMENT

STATESVILLE 704-878-5305 MOORESVILLE 704-664-5281

IMPROVEMENT PERMIT / AUTHORIZATION TO CONSTRUCT / OPERATION PERMIT / EXISTING SYSTEM INSPECTION

PERMIT# 23363 PIN# Pt of 2CA3 4626-31-6062 DATE 10/6/98

OWNER OR CONTRACTOR Jimmy Burbank PHONE: Business 945-1515 Home

ADDRESS 517 Sharon Amity Suite 100 Charlotte, NC.

LOCATION Windy Knoll Lane, Chuckwood Tr Morrows Ridge TR Lake Spring Lp. TR Windy Knoll at end of cul de sac.

SUBDIVISION HARBOUR BLOCK / SECTION 3 LOT 33 LOT AREA ~.9Ac SITE CLASS. PS DESIGN FLOW 480 L.T.A.R. .3

Septic Tank: 1000 Gallons; STB 794 Date 4/11/99
Pump Tank: 1000 Gallons; PT PT29 Date 5/11/99
Pump Make: Hydromatic Model SHE50A1 Serial No. 5/99
Nitrification Field: No Fields 1 Square Feet 1200 Linear Feet 400
No Lines 6 @ 67' Trench Width 36" Max Trench Bottom Depth 36" Gravel Depth SAND

☒ New System ☐ Repair System Type: I, II, (III), IV, V, VI
System Description: Presman-CH, PLASTIC
Repair System Description: SAME
Maintenance Agreement Required: ☒ Yes ☐ No


☒ House/Mod. Home No. Bedrooms 4
☐ Mobile Home No. Bathrooms 4
☐ Business No. Employees
☐ Other
☐ Slab ☐ Crawl Space ☒ Basement w/plumbing ☐ Basement wo/plumbing

Water Supply: ☐ Individual ☐ Public ☒ Community


Comments:/Conditions:

Comments:/Conditions:
7/23/99 Drainfield driven + packed over; gasline installed very near 2" supply line from pump, supply broken in rear of house

INITIAL SITE SKETCH

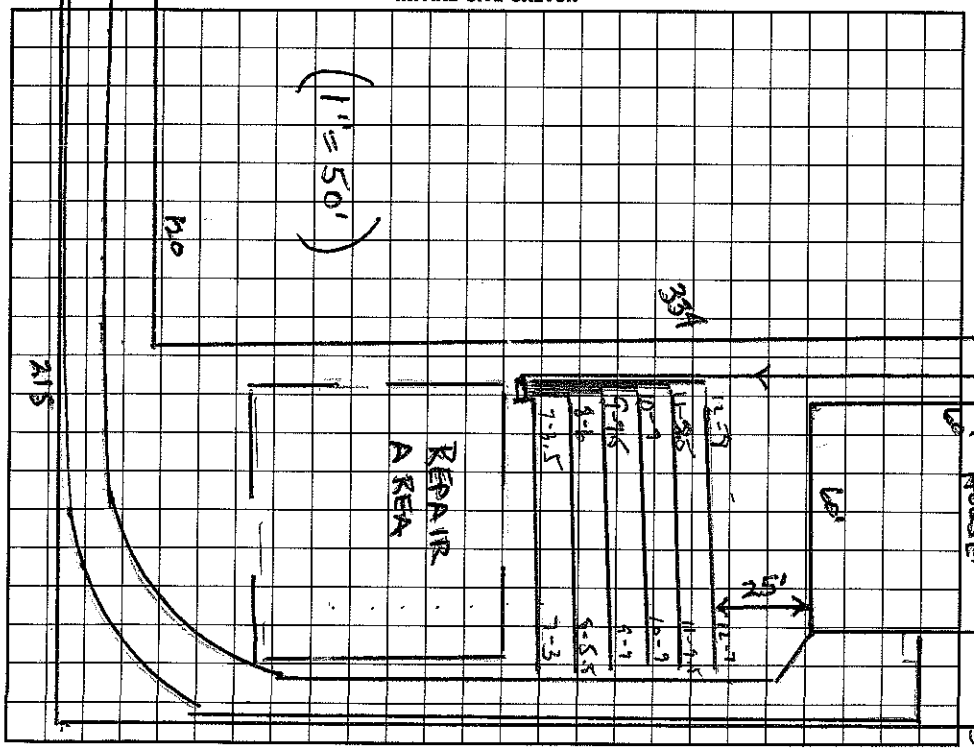

AS BUILT SKETCH

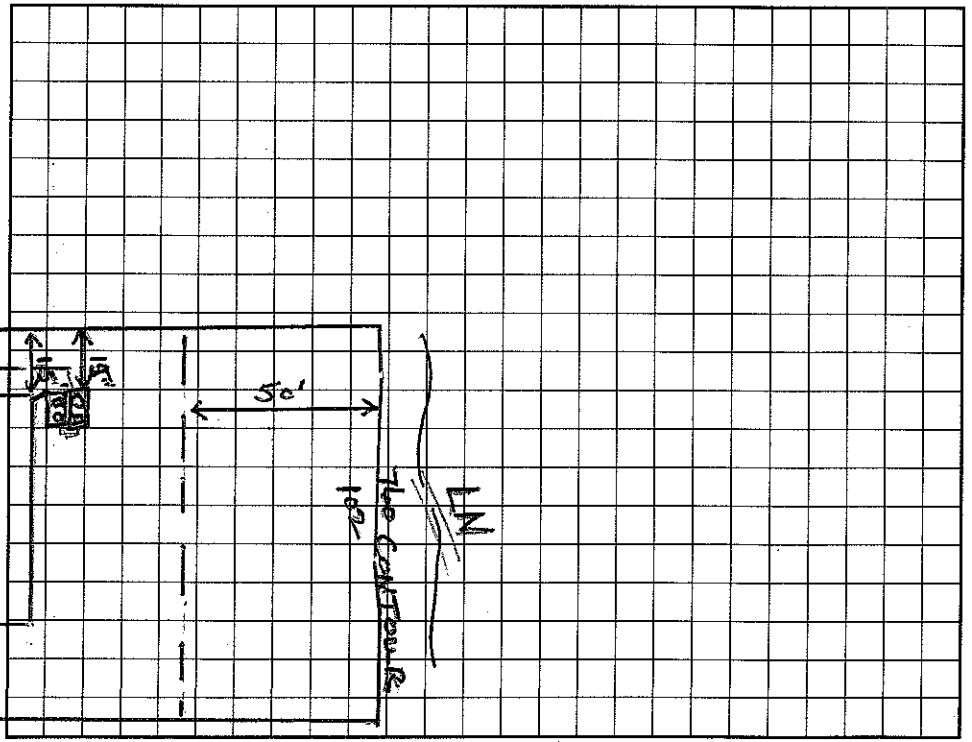

I understand that this permit can be suspended or revoked if any false information is supplied toward securing the permit/any unauthorized changes are made to the site/any unauthorized changes are made in the installation of the system. Improvement Permit with plat valid without expiration. Improvement Permit with site plan valid for sixty months. Authorization to Construct is valid for a period equal to that of Improvement Permit – not to exceed sixty months.

Signed: ✱ [signature] date 10/8/98 Installed by: MacLeod Const.

Improvement Permit by: DRH date 6-5-96 Operation Permit by: Wesley Sparks RS date 7/26/99

Authorization to Construct by: Wesley Sparks R.S. date 10/6/98 Existing System Inspection by: date

HEALTH DEPT. COPY: WHITE INSPECTION COPY (FINAL): GREEN OWNER COPY (FINAL): YELLOW INSPECTION COPY (INITIAL): PINK OWNER COPY (INITIAL): GOLD