# IREDELL COUNTY HEALTH DEPARTMENT

STATESVILLE 704-878-5305 MOORESVILLE 704-664-5281

## IMPROVEMENT PERMIT / AUTHORIZATION TO CONSTRUCT / OPERATION PERMIT / EXISTING SYSTEM INSPECTION

125 @ 11:00

COPY

PERMIT# 088898 PIN# 4626-31-6615 DATE 4/28/00

OWNER OR CONTRACTOR Easyway Inc. PHONE: Business 664-7727 Home

ADDRESS PO Box 3303

LOCATION Mooresville, NC. 28117 - 300 Chuckwood Rd.

SUBDIVISION Holiday Harbor BLOCK / SECTION LOT 91 LOT AREA 1.46 SITE CLASS PS DESIGN FLOW 360 L.T.A.R. .3

Septic Tank: 1000 Gallons; STB 1012 Date 2/6/00
Pump Tank: Gallons; PT Date
Pump Make: Model Serial No.
Nitrification Field: No Fields 1 Square Feet 900* Linear Feet 300*
No Lines 4@75'x3' Trench Width 36" Max Trench Bottom Depth 36" ~~Gravel Depth~~ SAND

☒ New System ☐ Repair System Type: I, II, (III) IV, V, VI
System Description: GRAVITY - HDS 2612 on CH. PLASTIC
Repair System Description: SAME
Maintenance Agreement Required: ☐ Yes ☒ No


☒ House/Mod. Home ☐ Mobile Home ☐ Business ☐ Other
No. Bedrooms 3 No. Bathrooms 1 No. Employees
☐ Slab ☒ Crawl Space ☐ Basement w/plumbing ☐ Basement wo/plumbing

Water Supply: ☒ Individual ☐ Public ☐ Community

Comments:/Conditions:

Comments:/Conditions: Installed as drawn. (used PI Chamb) Filter & riser installed

INITIAL SITE SKETCH (1"=50')

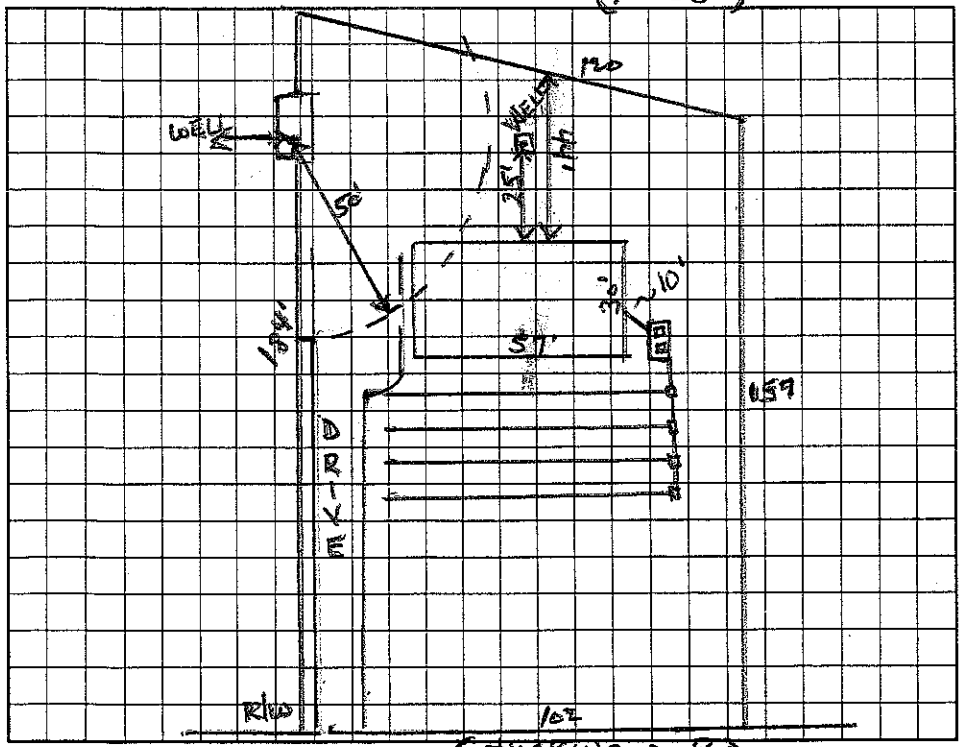


AS BUILT SKETCH

Permit can be suspended or revoked if any false information is supplied toward securing the permit/any unauthorized changes are made to the site/any unauthorized changes are made in the installation of the system. Improvement Permit with plat valid without expiration. Improvement Permit with site plan valid for sixty months. Authorization to Construct is valid for a period equal to that of Improvement Permit – not to exceed sixty months.

Signed: X date

Improvement Permit by: Wesley Sparks RS. date 4/28/00

Authorization to Construct by: Wesley Sparks RS. date 4/28/00

Installed by: Richard Abernathy date

Operation Permit by: Mark H Dotson RS date 6/8/2000

Existing System Inspection by: date

HEALTH DEPT. COPY: WHITE OWNER COPY (FINAL): YELLOW OWNER COPY (INITIAL): PINK